

12012

RECORDED
HILLSDALE CO. MICH.

LIBER 3 PAGE 271

98 NOV 25 AM 9 58



HILLSDALE COUNTY REMONUMENTATION CORNER
LAND CORNER RECORDATION CERTIFICATE
Filing Requirement of Act 74, Mich. P.A. 1970

Judy VanZandt
REG. OF DEEDS

For corners in

HILLSDALE COUNTY
WOODBRIDGE TWP (County)

Located In: Corner Code #

- 1. Public Land Survey T 8 S R 3 W I-5
- T R
- T R
- T R
- 2. Property Controlling S T R
- in Section S T R
- 3. Miscellaneous S T R
- Property in Sec. S T R

SURVEY &
REMONUMENTATION

FEB 23 1999

SECTION

Register of Deeds Stamp & File Number

4. Lot No. _____, Recorded Plat _____

5. Private Claims _____

I, EDWARD W. REED, in a field survey on OCTOBER 24, 1998
do hereby state that under requirements of P.A. 74, Michigan P.A. of 1970, the corner points mentioned in lines 1 and 2 above were in conformance with regulations and rules therefore as required in the current manual of survey instructions of the United States Department of the Interior, Bureau of Land Management or by a decree of a Court of Law and /or that the corner points mentioned in lines 3, 4 and 5 above were in conformance with the rules of the Michigan Board of Land Surveyors or by a Decree of a Court of Law; established, re-established, monumented, recovered, found as expressed below:

NOTE: Not more than 2 corners, all in the same town and range, may be recorded on this certificate.

	A	B	C	D	E	F	G	H	I	J	K	L	M
1													
2	6		5		4		3		2		1		
3													
4	7		8		9		10		11		12		
5													
6	18		17		16		15		14		13		
7													
8	19		20		21		22		23		24		
9													
10	30		29		28		27		26		25		
11													
12	31		32		33		34		35		36		
13													

CORNER COMMON TO SECTIONS 10-11-14-15

A. Description of original monument and accessories and/or subsequent restoration:

1825: GOVERNMENT SURVEY - CORNER SET
1873: R. BULLARD, SURVEYOR - GRANITE ROCK


B. Description of corner evidence found and/or method applied in restoring or reestablishing corner:

FOUND 5/8" IRON ROD IN CI-MONUMENT BOX, IRON IS CEMENTED INTO BOX
MONUMENT BOX IS IN CENTER OF INTERSECTION OF ROADS

C. Description of monument for corner and accessories established to perpetuate locating the position of the corner:

UNABLE TO REMOVE IRON, PLACED REMON CAP ON TOP OF EXISTING IRON ROD

SW CORNER GARAGE	N 43 E	86.40'
SE CORNER CONCRETE ANCHOR POST	N 61 W	66.20'
F A P MARKER	N 68 W	90.87'
TAG IN N SIDE POWER POLE	S 53 W	63.55'
NW CORNER STORE	S 48 E	87.57'

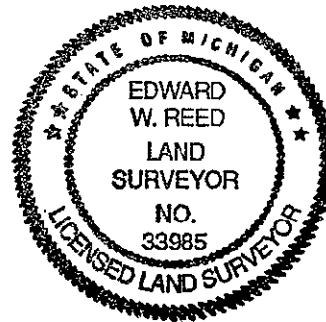

AND IS ACCEPTED AS THE BEST AVAILABLE EVIDENCE OF THE POSITION OF THE ORIGINAL CORNER.

Signed by *Edward W. Reed*

Date Nov. 9, 1998

Surveyor's Michigan License No. 33985

EDWARD R. REED