

12013

RECORDED
HILLSDALE CO. MIC

'98 NOV 25 AM 9



LIBER 3 PAGE 272

HILLSDALE COUNTY REMONUMENTATION CORNER
LAND CORNER RECORDATION CERTIFICATE
Filing Requirement of Act 74, Mich. P.A. 1970

John VanZon
REC. OF DEEDS

For corners in

HILLSDALE COUNTY
WOODBRIDGE TWP (County)

Located in: Corner Code #

- 1. Public Land Survey T 8 S R 3 W K-06
 T _____ R _____
 T _____ R _____
 T _____ R _____
- 2. Property Controlling S _____ T _____ R _____
 in Section S _____ T _____ R _____
- 3. Miscellaneous S _____ T _____ R _____
 Property in Sec. S _____ T _____ R _____

SURVEY &
REMONUMENTATION

FEB 23 1999

SECTION

Register of Deeds Stamp & File Number

4. Lot No. _____, Recorded Plat _____

5. Private Claims _____

	A	B	C	D	E	F	G	H	I	J	K	L	M
1													
2	6		5		4		3		2		1		
3													
4	7		8		9		10		11		12		
5													
6	18		17		16		15		14		13		
7													
8	19		20		21		22		23		24		
9													
10	30		29		28		27		26		25		
11													
12	31		32		33		34		35		36		
13													

I, EDWARD W. REED, in a field survey on NOVEMBER 2, 1998 do hereby state that under requirements of P.A. 74, Michigan P.A. of 1970, the corner points mentioned in lines 1 and 2 above were in conformance with regulations and rules therefore as required in the current manual of survey instructions of the United States Department of the Interior, Bureau of Land Management or by a decree of a Court of Law and /or that the corner points mentioned in lines 3, 4 and 5 above were in conformance with the rules of the Michigan Board of Land Surveyors or by a Decree of a Court of Law; established, re-established, monumented, recovered, found as expressed below:

NOTE: Not more than 2 corners, all in the same town and range, may be recorded on this certificate.

QUARTER CORNER COMMON TO SECTIONS 13 & 14

A. Description of original monument and accessories and/or subsequent restoration:

1825: GOVERNMENT SURVEY - CORNER SET
1873: R. BULLARD, CO SURVEYOR - ROCK


B. Description of corner evidence found and/or method applied in restoring or reestablishing corner:

MEASURED LINE NORTH & SOUTH, EXACTLY MIDWAY FOUND 2' X 3' BLUE STONE AND BRICK

C. Description of monument for corner and accessories established to perpetuate locating the position of the corner:

REMOVED STONE, SET 3/4" X 30" REBAR IRON WITH REMON CAP IN CI-MONUMENT BOX 4" BELOW GRAVEL ROAD SURFACE

STRAIGHT LINE BETWEEN CORNERS NORTH & SOUTH	EAST	7'
CENTER OF 3' CONCRETE CORNER POST	EAST	22.97'
IN LINE WITH FENCE LINE RUNNING EAST		
FACE OF 1' CONCRETE CORNER POST	WEST	22.00'
IN LINE WITH REMAINS OF FENCE LINE RUNNING WEST		
WITNESS TAG IN W. SIDE 40" OAK	N 05 E	106.82'
WITNESS TAG IN W. SIDE 6" HICKORY	N 35 E	45.10'

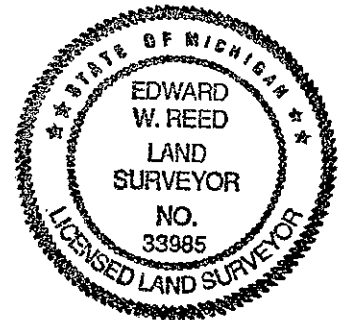

AND IS ACCEPTED AS A CAREFUL AND FAITHFUL PERPETUATION OF THE POSITION OF THE ORIGINAL CORNER..

Signed by *Edward W. Reed*
Surveyor's Michigan License No. 33985 EDWARD R. REED

Date NOVEMBER 9, 1998