

ACCEPTED BY THE HILLSDALE COUNTY SURVEY PEER GROUP AS THE OFFICIAL CORNER UNDER MICHIGAN PUBLIC ACT 345 OF 1988 AT A MEETING HELD ON \_\_\_\_\_ AL RINGENBERG, CO. REP.

LIBER 3 PAGE 259

007946  
RECORDED  
HILLSDALE CO. MICH.  
AUG 7 AM 10 10

HILLSDALE COUNTY REMONUMATION CORNER  
LAND CORNER RECORDATION CERTIFICATE

Filing Requirement of Act 74, Mich. P.A. 1970

For corners in

HILLSDALE COUNTY  
CAMDEN TOWNSHIP

Located In: Corner Code #

1. Public Land Survey T 8 S R 4 W E-7  
 T      R       
 T      R       
 T      R
2. Property Controlling in Section S      T      R       
 S       
 T      R
3. Miscellaneous S       
 T      R       
 Property in Sec. S       
 T      R

**SURVEY &  
REMONUMENTATION**

FEB 23 1999

*Judy VanZandt*  
REG. OF DEEDS

Register of Deeds Stamp & File Number

4. Lot No. \_\_\_\_\_, Recorded Plat \_\_\_\_\_  
 5. Private Claims \_\_\_\_\_ SECTION \_\_\_\_\_

I, EDWARD W. REED, in a field survey on JULY 26, 1998 do hereby state that under requirements of P.A. 74, Michigan P.A. of 1970, the corner points mentioned in lines 1 and 2 above were in conformance with regulations and rules therefore as required in the current manual of survey instructions of the United States Department of the Interior, Bureau of Land Management or by a decree of a Court of Law and /or that the corner points mentioned in lines 3, 4 and 5 above were in conformance with the rules of the Michigan Board of Land Surveyors or by a Decree of a Court of Law; established, re-established, monumented, recovered, found as expressed below:

	A	B	C	D	E	F	G	H	I	J	K	L	M
1													
2	6		5		4		3		2		1		
3													
4	7		8		9		10		11		12		
5													
6	18		17		16		15		14		13		
7													
8	19		20		21		22		23		24		
9													
10	30		29		28		27		26		25		
11													
12	31		32		33		34		35		36		
13													

NOTE: Not more than 2 corners, all in the same town and range, may be recorded on this certificate

CONRRER COMMON TO SECTIONS 16, 17, 20, 21

A. Description of original monument and accessories and/or subsequent restoration:

- 1825: ROBERT CLARK JR, DEPT SURVEYOR - CORNER SET  
 1869: GEO. A. MARK, CO SURVEYOR - SURVEY # 522, STONE & STAKE  
 1980: FRED CUTCHER, SURVEYOR - DUG FOR CORNER, UNABLE TO LOCATE ANYTHING, RESET CORNER FORM 1/16 CORNER AND 1/4 CORNER THAT I FOUND TO NORTH. SET HARRISON MARKER, RECORDED IN LCRC LIBER 2, PAGE 35


B. Description of corner evidence found and/or method applied in restoring or reestablishing corner:

FOUND HARRISON MARKER AS DESCRIBED BY CUTCHER IN LIBER 2, PAGE 35

C. Description of monument for corner and accessories established to perpetuate locating the position of the corner:

REPLACED HARRISON MARKER WITH 3/4" X 30" REBAR IRON WITH REMON CAP IN CI-MONUMENT BOX SET 4" BELOW GRAVEL ROAD GRADE

- 4' M/L SOUTH OF CENTERLINE OF ROAD TO EAST  
 NE. CORNER OF HOUSED FDN. S 37 W 80.35'  
 (FACE) OF 16" WALNUT S 85 W 40.5'  
 (CENTER) OF R.R TIE FENCE COR. POST N 30 E 73.65'  
 ABOUT IN LINE WITH FENCE TO WEST  
 CENTER OF 16" TWIN WALNUT N 25 E 67.5'

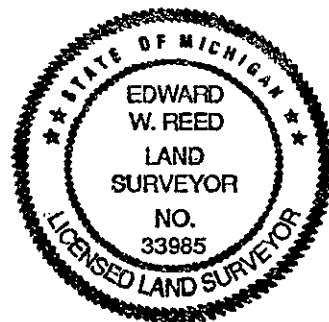

AND IS ACCEPTED AS THE BEST AVAILABLE EVIDENCE OF THE POSITION OF THE ORIGINAL CORNER.

Signed by *Edward W. Reed*  
 EDWARD W. REED

Date AUGUST 5, 1998

Surveyor's Michigan License No. 33985