ACCEPTED BY THE HILLSDALE COUNTY SURVEY PEER GROUP AS THE OFFICIAL CORNER UNDER MICHIGAN PUBLIC ACT 345 OF 1990 AT A MEETING HELD ON
AL RINGENBERG, CO. REP.

LIBER 3 PAGE 262

007949

RECORDED
HILLSDALE CO. MICH.
'98 AUG 7 AM 10 10
Judy VanZandt
REG. OF DEEDS

HILLSDALE COUNTY REMONUMATION CORNER LAND CORNER RECORDATION CERTIFICATE

Filing Requirement of Act 74, Mich. P.A. 1970

For corners in

HILLSDALE COUNTY
CAMDEN TOWNSHIP

	Located In:	Corner Code #
1. Public Land Survey	T 8 S R4 W	E-8
	T___ R___	
	T___ R___	
	T___ R___	
2. Property Controlling in Section	S___ T___ R___	
	S___	
	T___ R___	
3. Miscellaneous	S___	
	T___ R___	
Property in Sec.	S___	
	T___ R___	

SURVEY & REMONUMENTATION
FEB 23 1999

Register of Deeds Stamp & File Number

4. Lot No. _____, Recorded Plat _____ SECTION
5. Private Claims _____

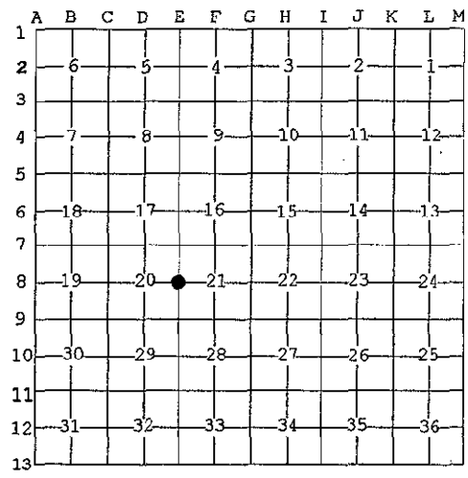

I, EDWARD W. REED, in a field survey on JULY 26, 19 98 do hereby state that under requirements of P.A. 74, Michigan P.A. of 1970, the corner points mentioned in lines 1 and 2 above were in conformance with regulations and rules therefore as required in the current manual of survey instructions of the United States Department of the Interior, Bureau of Land Management or by a decree of a Court of Law and /or that the corner points mentioned in lines 3, 4 and 5 above were in conformance with the rules of the Michigan Board of Land Surveyors or by a Decree of a Court of Law; established, re-established, monumented, recovered, found as expressed below:

NOTE: Not more than 2 corners, all in the same town and range, may be recorded on this certificate.

QUARTER CORNER COMMON TO SECTIONS 20 & 21

A. Description of original monument and accessories and/or subsequent restoration:

1825: ROBERT CLARK, JR, DEPT SURVEYOR - CORNER SET
1869: GEO. A, MARK, CO SURVEYOR - SURVEY # 523, STONE
1980: FRED CUTCHER, SURVEYOR - FOUND BLUE-GREEN STONE & VERTICAL SOIL DISCOLORATION, POSSIBLY OLD STAKE, SET HARRISON MARKER AND RECORDED IN LCRC LIBER 2, PAGE 33

B. Description of corner evidence found and/or method applied in restoring or reestablishing corner:

FOUND HARRISON MARKER AS DESCRIBED BY CUTCHER IN LCRC LIBER 2, PAGE 33

C. Description of monument for corner and accessories established to perpetuate locating the position of the corner:

REPLACE HARRISON MARKER WITH 3/4" X 30" REBAR IRON WITH REMON CAP IN CI-MONUMENT BOX, 4" BELOW GRAVEL ROAD SURFACE

9' M/L EAST OF CENTERLINE OF N/S ROAD
12' M/L NORTH OF FENCE TO EAST

(FACE) OF 24" MAPLE	S 80W	35.5'
NW CORNER OF R.R. TIE POST,	S50 E	14.0'
SW CORNER OF R.R TIE POST	N 50 E	14.8'
SW CORNER HOUSE,	N 20 W	161.42'
CENTER OF 24" WALNUT,	S 18 E	26.3

STATE OF MICHIGAN
EDWARD W. REED
LAND SURVEYOR
NO. 33985
LICENSED LAND SURVEYOR

AND IS ACCEPTED AS A CAREFUL AND FAITHFUL PERPETUATION OF THE POSITION OF THE ORIGINAL CORNER

Signed by Edward W Reed
EDWARD W. REED

Date AUGUST 5, 1998

Surveyor's Michigan License No. 33985

FORM APPROVED BY MICHIGAN STATE BOARD OF PROFESSIONAL SURVEYORS, JAN. 28, 197
REVISED MAY 14,197
REVISED JAN., 198
REVISED OCT., 199