

007951

RECORDED
HILLSDALE CO. MICH.

'98 AUG 7 AM 10 10

Judy VanZandt
REG. OF DEEDS

LIBER 3 PAGE 264

**HILLSDALE COUNTY REMONUMATION CORNER
LAND CORNER RECORDATION CERTIFICATE
Filing Requirement of Act 74, Mich. P.A. 1970**



For corners in

HILLSDALE COUNTY
Camden twp.

Located In:

Corner Code #

- 1. Public Land Survey T 8 S R 4 W G-7
 T _____ R _____
 T _____ R _____
 T _____ R _____
- 2. Property Controlling S _____ T _____ R _____
 in Section S _____
 T _____ R _____
- 3. Miscellaneous S _____
 T _____ R _____
 Property in Sec. S _____
 T _____ R _____

**SURVEY &
REMONUMENTATION**

FEB 23 1999

SECTION

- 4. Lot No. _____, Recorded Plat _____
- 5. Private Claims _____

I, EDWARD W. REED, in a field survey on August 3, 19 98 do hereby state that under requirements of P.A. 74, Michigan P.A. of 1970, the corner points mentioned in lines 1 and 2 above were in conformance with regulations and rules therefore as required in the current manual of survey instructions of the United States Department of the Interior, Bureau of Land Management or by a decree of a Court of Law and /or that the corner points mentioned in lines 3, 4 and 5 above were in conformance with the rules of the Michigan Board of Land Surveyors or by a Decree of a Court of Law; established, re-established, monumented, recovered, found as expressed below:

NOTE: Not more than 2 corners, all in the same town and range, may be recorded on this certificate.

CORNER COMMON TO SECTIONS 15-16-21-22


- A. Description of original monument and accessories and/or subsequent restoration:
 1825: WM BROOKFIELD, SET CORNER
 01-74: M. VERNIER, SURVEY CHIEF OF RINGENBERG & BURRIS: FIELD NOTES INDICATE FOUND IRON PIPE.
 5-30-74: ROBERT BURRIS, SURVEYOR: SURVEY TIED TO CORNER.

- B. Description of corner evidence found and/or method applied in restoring or reestablishing corner:
 IRON PIPE NOW GONE, ALL WITNESS REMAINING NO OTHER EVIDENCE OF CORNER

- C. Description of monument for corner and accessories established to perpetuate locating the position of the corner:

- SET 3/4" X 30" REBAR IRON WITH REMON CAP FROM WITNESS OF RINGENBERG & BURRIS.
- RESET NEW NAILS AND WITNESS TAGS IN OLD CALLS
- PK NAIL & WASHER IN NW SIDE OF 8" SHAG HICKORY S 45 W 13.5'
- PK NAIL & WASHER IN SW SIDE 8" OAK S 20 E 14.65'
- PK NAIL & WASHER IN SW SIDE 6" HICKORY S 45 E 9.1'
- PK NAIL & WASHER IN SE SIDE 24" OAK N 40 E 16.05'
- (NEW WITNESS)
- NAIL & WASHER IN S. SIDE OF WOOD RAILROAD TIE POST NORTH 0.20'
- NAIL & WASHER IN W. SIDE OF WOOD RAILROAD TIE POST EAST 7.83'
- NAIL & WASHER IN N. SIDE OF WOOD RAILROAD TIE POST SOUTH 7.65'

	A	B	C	D	E	F	G	H	I	J	K	L	M
1													
2	6		5		4		3		2		1		
3													
4	7		8		9		10		11		12		
5													
6	18		17		16		15		14		13		
7													
8	19		20		21		22		23		24		
9													
10	30		29		28		27		26		25		
11													
12	31		32		33		34		35		36		
13													

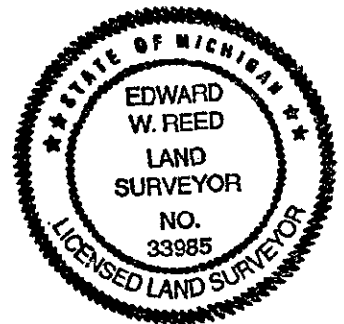

AND IS ACCEPTED AS A CAREFUL AND THE BEST AVAILABLE EVIDENCE OF THE POSITION OF THE ORIGINAL CORNER.

Signed by *Edward W. Reed*
EDWARD W. REED

Date AUGUST 5, 1998

Surveyor's Michigan License No. 33985