

12407

RECORDED
HILLSDALE CO. MICH.

'98 DEC 4 AM 11 48

Jeffrey VanZandt
REG. OF DEEDS

SURVEY &
REMONUMENTATION

FEB 23 1999

SECTION

Register of Deeds Stamp & File Number



LIBER 3 PAGE 305

REMONUMENTATION
LAND CORNER RECORDATION CERTIFICATE
Filing Requirement of Act 74, Mich. P.A. 1970

For corners in

HILLSDALE
(County)

Located In:

Corner Code #

1. Public Land Survey

T 8S R 4W G-9

T _____ R _____

T _____ R _____

T _____ R _____

2. Property Controlling in Section

S _____ T _____ R _____

S _____ T _____ R _____

3. Miscellaneous Property in Sec.

S _____ T _____ R _____

S _____ T _____ R _____

4. Lot No. _____, Recorded Plat _____

5. Private Claims _____

I, Jeffrey A. Bieszk, in a field survey on 25 Nov, 1998 do hereby state that under requirements of P.A. 74, Michigan P.A. of 1970, the corner points mentioned in lines 1 and 2 above were in conformance with regulations and rules therefore as required in the current manual of survey instructions of the United States Department of the Interior, Bureau of Land Management or by a decree of a Court of Law and /or that the corner points mentioned in lines 3, 4 and 5 above were in conformance with the rules of the Michigan Board of Land Surveyors or by a Decree of a Court of Law; established, re-established, monumented, recovered, found as expressed below:

NOTE: Not more than 2 corners, all in the same town and range, may be recorded on this certificate.

	A	B	C	D	E	F	G	H	I	J	K	L	M
1													
2	6		5		4		3		2		1		
3													
4	7		8		9		10		11		12		
5													
6	16		17		16		15		14		13		
7													
8	19		20		21		22		23		24		
9													
10	30		29		28		27		26		25		
11													
12	31		32		33		34		35		36		
13													

A. Description of original monument and accessories and/or subsequent restoration:

GLO
post
7" Ironwood N25E 19 lks
18" Beech S45E 31 lks


County Surveyor (Geo. A. Mark 1871)
Stone, Brick & Earthen

B. Description of corner evidence found and/or method applied in restoring or reestablishing corner:

Did not find anything. Set corner from I-9 through H-9 double over. Corner fits occupation to the North. Accepted as the best available evidence to the position of the original corner.

C. Description of monument for corner and accessories established to perpetuate locating the position of the corner:

Set 5/8" x 36" iron w/cap in Monument Box
Nail & Tag Power Pole North 34.38 ft.
Nail & Tag 16" Maple N 55 W 41.00 ft.
Nail & Tag 30" Maple S 45 W 47.65 ft.
Nail & Tag 10" Maple S 35 E 38.92 ft.

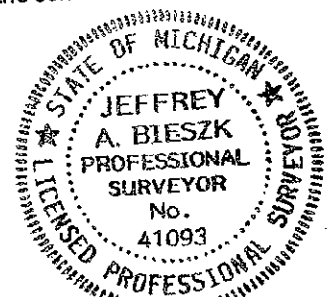

Signed by *Jeffrey A. Bieszk*
Surveyor's Michigan License No. 41093

Date 4 December 1998