

007950

RECORDED
HILLSDALE CO. MICH.

'98 AUG 7 AM 10 10

Judy VanZandt
REG. OF DEEDS

LIBER 3 PAGE 263

**HILLSDALE COUNTY REMONUMATION CORNER
LAND CORNER RECORDATION CERTIFICATE
Filing Requirement of Act 74, Mich. P.A. 1970**



For corners in

HILLSDALE COUNTY
CAMDEN TWP.

Located In:

Corner Code

1. Public Land Survey

T 8 S R 4 W H-7

T _____ R _____

T _____ R _____

T _____ R _____

2. Property Controlling
in Section

S _____ T _____ R _____

S _____

T _____ R _____

3. Miscellaneous

S _____

T _____ R _____

Property in Sec.

S _____

T _____ R _____

**SURVEY &
REMONUMENTATION**

FEB 23 1999

Register of Deeds Stamp & File Number

4. Lot No. _____, Recorded Plat _____ SECTION _____

5. Private Claims _____

I, EDWARD W. REED, in a field survey on AUGUST 3, 19 98
do hereby state that under requirements of P.A. 74, Michigan P.A. of 1970, the corner points
mentioned in lines 1 and 2 above were in conformance with regulations and rules therefore as
required in the current manual of survey instructions of the United States Department of the
Interior, Bureau of Land Management or by a decree of a Court of Law and /or that the corner
points mentioned in lines 3, 4 and 5 above were in conformance with the rules of the Michigan
Board of Land Surveyors or by a Decree of a Court of Law; established, re-established,
monumented, recovered, found as expressed below:

**NOTE: Not more than 2 corners, all in the same town and range, may be recorded
on this certificate.**

	A	B	C	D	E	F	G	H	I	J	K	L	M
1													
2	6		5		4		3		2		1		
3													
4	7		8		9		10		11		12		
5													
6	18		17		16		15		14		13		
7													
8	19		20		21		22		23		24		
9													
10	30		29		28		27		26		25		
11													
12	31		32		33		34		35		36		
13													

QUARTER CORNER COMMON TO SECTIONS 15 & 22

A. Description of original monument and accessories and/or subsequent restoration:

1825: WM. BROOKFIELD, CORNER SET

5-28-74: M. VERNIER, SURVEY CHIEF OF RINGENBERG & BURRIS, SURVEYORS: FIELD NOTES INDICATE IRON BAR AND ID CAP

5-30-74: ROBERT BURRIS, SURVEYOR: SURVEY TIED TO CORNER

B. Description of corner evidence found and/or method applied in restoring or reestablishing corner:


FOUND 1/2" IRON ROD FITTING WITNESS OF RINGENBERG & BURRIS, NO OTHER EVIDENCE OF CORNER

C. Description of monument for corner and accessories established to perpetuate locating the position of the corner:

SET 3/4" X 30" REBAR IRON WITH REMON CAP AT POINT

2' SOUTH OF FENCE RUNNING EAST & WEST, IN LINE WITH FENCE RUNNING NORTH

PK NAIL IN E. SIDE OF TWIN MAPLE	S 20 E	10.44'
PK NAIL & WASHER IN S. SIDE 30" TWIN OAK	N 85 E	21.38'
PK NAIL & WASHER IN S. SIDE 20" TWIN OAK	S 45 E	44.48'
PK NAIL & WASHER IN S SIDE 20" OAK	N 85 W	32.17'
PK NAIL & WASHER IN W SIDE 30" OAK	S 30 E	36.80'

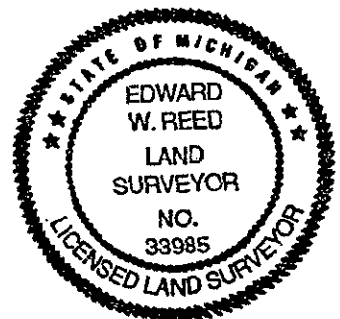

AND IS ACCEPTED AS THE BEST AVAILABLE EVIDENCE OF THE POSITION OF THE ORIGINAL CORNER.

Signed by *Edward W. Reed*

EDWARD W. REED

Date AUGUST 5, 1998

Surveyor's Michigan License No. 33985