

007948

RECORDED
HILLSDALE CO. MICH.

'98 AUG 7 AM 10 10

Judy VanZandt
REG. OF DEEDS

ACCEPTED BY THE HILLSDALE COUNTY SURVEY PEER GROUP AS THE OFFICIAL CORNER UNDER MICHIGAN PUBLIC ACT 345 OF 1998 AT MEETING HELD ON _____ AL RINGENBERG, CD REP

LIBER 3 PAGE 261

HILLSDALE COUNTY REMONUMATION CORNER
LAND CORNER RECORDATION CERTIFICATE
Filing Requirement of Act 74, Mich. P.A. 1970

For corners in

HILLSDALE COUNTY
CAMDEN TOWNSHIP

Located In: _____ Corner Code # _____

- 1. Public Land Survey T 8 S R 4 W 1-7
T _____ R _____
T _____ R _____
T _____ R _____
- 2. Property Controlling in Section S _____ T _____ R _____
S _____
T _____ R _____
- 3. Miscellaneous S _____ T _____ R _____
T _____ R _____
Property in Sec. S _____ T _____ R _____

SURVEY & REMONUMENTATION
FEB 23 1999

Register of Deeds Stamp & File Number

- 4. Lot No. _____, Recorded Plat _____ SECTION _____
- 5. Private Claims _____

I, EDWARD W. REED, in a field survey on JUNE 26, 19 98 do hereby state that under requirements of P.A. 74, Michigan P.A. of 1970, the corner points mentioned in lines 1 and 2 above were in conformance with regulations and rules therefore as required in the current manual of survey instructions of the United States Department of the Interior, Bureau of Land Management or by a decree of a Court of Law and /or that the corner points mentioned in lines 3, 4 and 5 above were in conformance with the rules of the Michigan Board of Land Surveyors or by a Decree of a Court of Law; established, re-established, monumented, recovered, found as expressed below:

1	A	B	C	D	E	F	G	H	I	J	K	L	M
2		6		5		4		3		2		1	
3													
4		7		8		9		10		11		12	
5													
6		18		17		16		15		14		13	
7													
8		19		20		21		22		23		24	
9													
10		30		29		28		27		26		25	
11													
12		31		32		33		34		35		36	
13													

NOTE: Not more than 2 corners, all in the same town and range, may be recorded on this certificate.

CORNER COMMON TO SECTIONS 14, 15, 22, 23

A. Description of original monument and accessories and/or subsequent restoration:
1825: WM BROOKFIELD, CORNER SET
1972: A. JOHN HATT, SURVEYOR - FOUND POINTED STONE ON FLAT STONE WITH SMALL AMOUNTS OF GLASS, BRICK AND TILE, ABOUT 12" UNDER GRAVEL ROAD SURFACE. SET 1/2" PIPE AT SIDE OF STONE, RECORDED IN LCRC LIBER 1, PAGE 159


B. Description of corner evidence found and/or method applied in restoring or reestablishing corner:

FOUND 1/2 " IRON PIPE AT SIDE OF STONES AS DESCRIBED IN LCRC LIBER 1, PAGE 159

C. Description of monument for corner and accessories established to perpetuate locating the position of the corner:

SET 3/4" X 30" REBAR IRON WITH REMON CAP IN CI-MONUMENT BOX 4" BELOW GRAVEL ROAD SURFACE

- I.D. WASHER, N.E. SIDE OF 18" PIPE S 55 E 86.95'
- I.D. WASHER E. SIDE OF 10" WALNUT S 20 E 33.45'
- SW CORNER TEL. PED. N 20 E 37.00'
- SW CORNER STONE FENCE N 60 E 104.7'
- C/L OF M-49 HIGHWAY WEST 82.3' TO REFLECTOR
- C/L OF ROAD EAST NORTH 6'

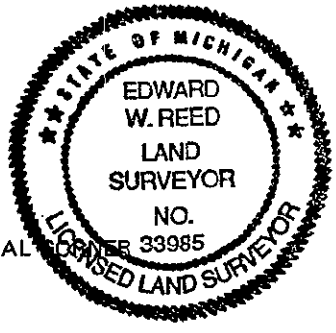

AND IS ACCEPTED AS A CAREFUL AND FAITHFUL PERPETUATION OF THE POSITION OF THE ORIGINAL

Signed by *Edward W. Reed*
EDWARD W. REED

Date AUGUST 5, 1998

Surveyor's Michigan License No. 33985