

118865

LIBER 3 PAGE 159

RECORDED
HILLSDALE CO. MICH.

'97 JAN 13 AM 11 56



REMONUMENTATION
LAND CORNER RECORDATION CERTIFICATE
Filing Requirement of Act 74, Mich. P.A. 1970

Judy VanZandt
REG. OF DEEDS

For corners in
HILLSDALE
(county)

Located In


Corner Code #

1. Public Land Survey	T <u>9S</u>	R <u>2W</u>	<u>B-3</u>
	T _____	R _____	_____
	T _____	R _____	_____
	T _____	R _____	_____
2. Property Controlling S	<u>T</u>	R _____	_____
in Section	S <u>T</u>	R _____	_____
3. Miscellaneous	S <u>T</u>	R _____	_____
Property in Sec.	S <u>T</u>	R _____	_____

Register of Deeds Stamp & File Number

4. Lot No. _____, Recorded Plat _____
5. Private Claims _____

I, R.T. Tietsema, in a field survey on SEPTEMBER 19, 1996, hereby certify that under the requirements of P.A. 74, Michigan P.A. of 1970, the corner points mentioned in lines 1 and 2 above were in conformance with the regulations and rules therefore as required in the current manual of survey instructions of the United States Department of the Interior, Bureau of Land Management or by a decree of a Court of Law and/or that the corner points mentioned in lines 3, 4, and 5 above were in conformance with the rules of the Michigan Board of Land Surveyors or by a Decree of a Court of Law; established, re-established, monumented, recovered, found as expressed below.

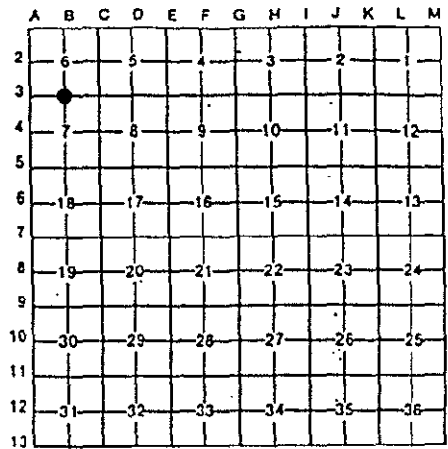

NOTE: Not more than 4 corners, all in the same town and range, may be recorded on this certificate

1. Description of original monument and accessories and/or restoration:

Set post Corner between Sections 6,7

22/03/1825	GLO (Brookfield)	Fld. Notes	Set Original Corner	1) 15" Beech	S27 1/2E 24 links(15.84')
				2) 14" Beech	N72 1/2W 40 links(26.4')
1/21/1887	County Surveyor (G. Mark)	Boundary	Found Stone	3) Stone and Bricks N	50links(33.0')
				4) 8" Apple	N69E 162 1/2 links(107.25')
8/07/1890	County Surveyor	Boundary	Unrecorded	5) Stone and Bricks N	50links(33.0')
1/08/74	Donald Olmstead	Boundary	R.R. spike	no witnesses	

2. Description of corner evidence found and/or method applied in restoring or reestablishing corner:

In September 1996, LSC found a Railroad Spike in the centerline of Territorial Road 0.10' below road surface with no existing recorded witnesses. LSC's measured distances check proportionately with GLO and 1974 Donald Olmstead Survey for South Line of Section 6, Amboy Twp.

3. Description of monument for corner and accessories established to perpetuate locating the position of the corner:

Set 1/2" Rebar with Remon. Cap in Mon. Box, established three (3) witnesses.

6" wide stump	N05E	47.78'	to nail/washer in East side
8" multi-trunk Elm	S65W	63.47'	to nail/washer in East side
15" Cottonwood	S37W	40.90'	to nail/washer in East side

SURVEY &
REMONUMENTATION

MAY 16 1997

COMMISSION

It is our opinion that this represents the best evidence of the position of the original corner.

Signed by *R. T. Tietsema* Date DEC 20 1996
Surveyor's Michigan License No. 20712