

'97 JAN 13 AM 11 57

REMONUMENTATION

LAND CORNER RECORDATION CERTIFICATE
Filing Requirement of Act 74, Mich. P.A. 1970



Judy VanZandt
REG. OF DEEDS

For corners in HILLSDALE (county)	Located In	Corner Code #
1. Public Land Survey	T <u>9S</u> R <u>2W</u> H-3	
	T _____ R _____	
	T _____ R _____	
	T _____ R _____	
2. Property Controlling S _____ T _____	R _____	
in Section S _____ T _____	R _____	
3. Miscellaneous S _____ T _____	R _____	
Property in Sec. S _____ T _____	R _____	


SURVEY & REMONUMENTATION

SEP 03 1999
Register of Deeds Stamp & File Number

SECTION

4. Lot No. _____, Recorded Plat _____
5. Private Claims _____

I, R.T. Tietsema, in a field survey on SEPTEMBER 19, 1996, do hereby certify that under the requirements of P.A.74, Michigan P.A. of 1970, the corner points mentioned in lines 1 and 2 above were in conformance with the regulations and rules therefore as required in the current manual of survey instructions of the United States Department of the Interior, Bureau of Land Management of by a decree of a Court of Law and/or that the corner points mentioned in lines 3, 4, and 5 above were in conformance with the rules of the Michigan Board of Land Surveyors or by a Decree of a Court of Law; established, re-established, monumented, recovered, found as expressed below.

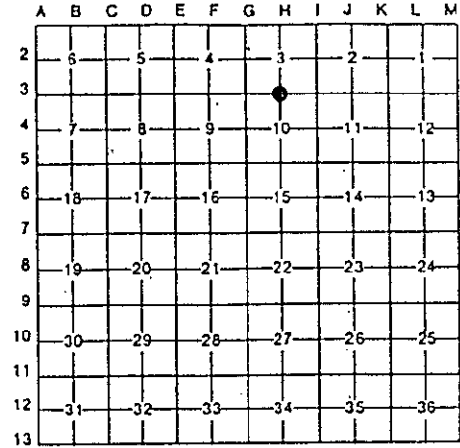

NOTE: Not more than 4 corners, all in the same town and range, may be recorded on this certificate

A. Description of original monument and accessories and/or restoration:

Set post Corner between Sections 3 & 10					
02/28/1825	GLO (Brookfield)	Fld. Notes	Set Original Corner	1) 15" Beech N11W 16 links(10.56')	2) 28" Beech S80 1/2W 38 links(25.08')
August 1957	D.C.P. 3165	Resurvey	Reset with 5/8" Rod	3) 14" Maple N43E 48.15'	4) T.P. S67E 1.78'
				5) 10" Ash S79W 62.31'	6) Fence Cor. S00E 17.49'
12/12/79	Bruce A. Leone 22409	Boundary	Monument Box	no witnesses	

B. Description of corner evidence found and/or method applied in restoring or reestablishing corner:

In September 1996, LSC found a Monument Box with a Boat spike 0.40' below road surface and one remaining recorded witness. LSC measured distances (2641.76 & 2641.35, 1996) check proportionatly with GLO (2636.04 & 2636.04, 1825).

C Description of monument for corner and accessories established to perpetuate locating the position of the corner:

Set 1/2" Rebar with Remon Cap in Mon Box, established three (3) additional witnesses.

3) 16" Maple	N45E	47.00'	to nail/washer in W side
7) 28" Willow	N75E	115.83'	to nail/washer in W side
8) 30" Maple	N10E	91.36'	to nail/washer in W side
9) SE cor. Pole Barn	N65W	161.32'	

It is our opinion that this represents the best evidence of the position of the original corner.

Signed by [Signature] Date DEC 20 1996
Surveyor's Michigan License No. 20712

