

ACCEPTED BY THE HILLSDALE COUNTY SURVEY PEER GROUP AS THE OFFICIAL CORNER UNDER MICHIGAN PUBLIC ACT 345 OF 1990 AT A MEETING HELD ON [Signature] AL RINGENBERG CO. REC.

REMONUMENTATION LAND CORNER RECORDATION CERTIFICATE Filing Requirement of Act 74, Mich. P.A. 1970

118872 372 RECORDED HILLSDALE CO. MICH. '97 JAN 13 AM 11 57 [Signature] REG. OF DEEDS


For corners in HILLSDALE (county) Located In Corner Code # 1. Public Land Survey T 9S R 2W I-3 2. Property Controlling S in Section S T R 3. Miscellaneous Property in Sec. S T R 4. Lot No. Recorded Plat 5. Private Claims

SURVEY & REMONUMENTATION

SEP 03 1999 Register of Deeds Stamp & File Number

SECTION

I, R.T. Tietsema, in a field survey on SEPTEMBER 19, 1996, do hereby certify that under the requirements of P.A.74, Michigan P.A. of 1970, the corner points mentioned in lines 1 and 2 above were in conformance with the regulations and rules therefore as required in the current manual of survey instructions of the United States Department of the Interior, Bureau of Land Management of by a decree of a Court of Law and/or that the corner points mentioned in lines 3, 4, and 5 above were in conformance with the rules of the Michigan Board of Land Surveyors or by a Decree of a Court of Law; established, re-established, monumented, recovered, found as expressed below.

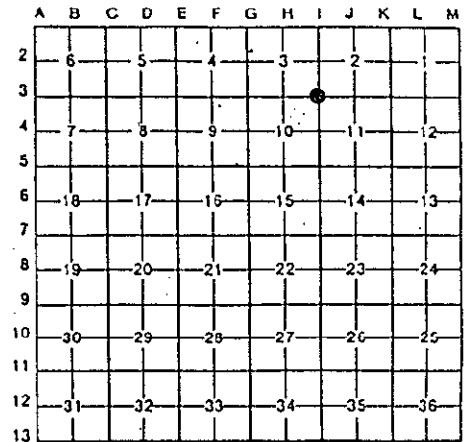

NOTE: Not more than 4 corners, all in the same town and range, may be recorded on this certificate

A. Description of original monument and accessories and/or restoration:

Table with columns for date, location, notes, monument type, and witnesses. Includes entries for 02/26/1825 GLO (Brookfield) and August 1957 D.C.P. 3165.

B. Description of corner evidence found and/or method applied in restoring or reestablishing corner:

In September 1996, LSC found a Boat Spike in a Mon. Box 0.40' below road surface and one remaining recorded witness. LSC's measured distances (2633.90 & 2635.82, 1996) check proportionately with GLO (2636.04 & 2636.04, 1825).

C. Description of monument for corner and accessories established to perpetuate locating the position of the corner:

Set 1/2" Rebar with Remon Cap in Mon Box, established three additional (3) witnesses. 5) 20" Maple N40E 44.83' to nail/washer in W side 6) 18" Walnut S17W 103.46' to nail/washer in E side 7) 20" Maple S07E 96.07' to nail/washer in W side 8) Multi-Trunk Mulberry S60E 103.08' to nail/washer in N side

It is our opinion that this represents the best evidence of the position of the original corner.

Signed by [Signature] Date DEC 20 1996 Surveyor's Michigan License No. 20712

