

118873

RECORDED
HILLSDALE CO. MICH.

'97 JAN 13 AM 11 57

Judy VanZandt
REG. OF DEEDS

ACCEPTED BY THE HILLSDALE COUNTY SURVEY PEER GROUP AS THE OFFICIAL CORNER UNDER MICHIGAN PUBLIC ACT 345 OF 1994 AT A MEETING HELD ON 05/04/94 AT AL RINGENBERG, CO. REG.

REMONUMENTATION
LAND CORNER RECORDATION CERTIFICATE
Filing Requirement of Act 74, Mich. P.A. 1970


For corners in <u>HILLSDALE</u> (county)	Located in	Corner Code #
1. Public Land Survey	T <u>9S</u>	R <u>2W</u>
	T _____	R _____
	T _____	R _____
	T _____	R _____
2. Property Controlling S in Section	S <u>T</u>	R _____
	S <u>T</u>	R _____
3. Miscellaneous Property in Sec.	S <u>T</u>	R _____
	S <u>T</u>	R _____

J-3

Register of Deeds Stamp & File Number

4. Lot No. _____, Recorded Plat _____
5. Private Claims _____

R.T. Tietsema, in a field survey on JUNE 20, 1996, do hereby certify that under the requirements of P.A.74, Michigan P.A. of 1970, the corner points mentioned in lines 1 and 2 above were in conformance with the regulations and rules therefore as required in the current manual of survey instructions of the United States Department of the Interior, Bureau of Land Management of by a decree of a Court of Law and/or that the corner points mentioned in lines 3, 4, and 5 above were in conformance with the rules of the Michigan Board of Land Surveyors or by a Decree of a Court of Law; established, re-established, monumented, recovered, found as expressed below.

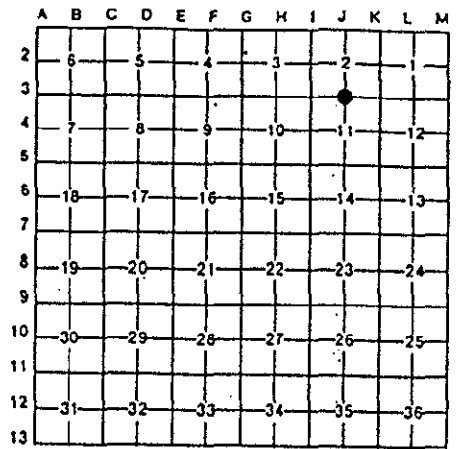

NOTE: Not more than 4 corners, all in the same town and range, may be recorded on this certificate

A. Description of original monument and accessories and/or restoration:

Set post Corner between Sections 2 & 11

Date	Surveyor	Notes	Resurvey	Reset with	Witnesses	Distances
2/26/1825	GLO (Brookfield)	Fld. Notes	Set Original Corner	1) 5" Beech 2) 7" Beech	N50 1/2W N30E	9 links(5.94') 9 links(5.94')
August 1957	D.C.P. 3165	Resurvey	Reset with 3/8" Steel Rod	3) Fence Cor. 4) 18Elm 5) 39" Maple	S0W N74W N65E	28.08 94.86' 46.38'

B. Description of corner evidence found and/or method applied in restoring or reestablishing corner:

June 1996, LSC found a Monument Box with a 1/2 " Rebar 2.0' below bit. surface one recorded witness remained, then raised corner with 1/2" Rebar to 0.30 below bit surface. LSC's measured distances (2633.90 & 2635.82, 1996) check proportionatly with GLO (2636.04 & 2636.04, 1825).

C. Description of monument for corner and accessories established to perpetuate locating the position of the corner:

Set 1/2 " Rebar with Remon Cap in Mon Box, established three (3) additional witnesses.

- 3) E side cor. fence post S05W 28.11' to nail/washer
- 6) E side Power Pole N05E 67.82' to nail/washer
- 7) W end 12" CMP S20E 24.88'
- 8) E end 12" CMP S55E 41.79'

is our opinion that this represents the best evidence of the position of the original corner.

SURVEY &
REMONUMENTATION

MAY 16 1997

Signed by [Signature] Date DEC 20 1996
Surveyor's Michigan License No. 20712