

118874

RECORDED  
HILLSDALE CO. MICH.

'97 JAN 13 AM 11 57

ACCEPTED BY THE HILLSDALE COUNTY SURVEY PEER GROUP AS THE OFFICIAL CORNER UNDER MICHIGAN PUBLIC ACT 348 OF 1990. MEETING HELD ON \_\_\_\_\_  
AL RINGENBERG, CO. REP.

REMONUMENTATION  
LAND CORNER RECORDATION CERTIFICATE  
Filing Requirement of Act 74, Mich. P.A. 1970

Judy VanZandt  
REG. OF DEEDS

For corners in <u>HILLSDALE</u> (county)	Located In		Corner Code #
1. Public Land Survey	T <u>9S</u>	R <u>2W</u>	<u>K-3</u>
	T _____	R _____	_____
	T _____	R _____	_____
	T _____	R _____	_____
2. Property Controlling S in Section	S <u>T</u>	R _____	_____
	S <u>T</u>	R _____	_____
3. Miscellaneous Property in Sec.	S <u>T</u>	R _____	_____
	S <u>T</u>	R _____	_____


SURVEY &  
REMONUMENTATION

SEP 03 1999  
Register of Deeds Stamp & File Number

4. Lot No. \_\_\_\_\_, Recorded Plat \_\_\_\_\_  
5. Private Claims \_\_\_\_\_

SECTION

I, R.T. Tietsema, in a field survey on JUNE 20, 1996, do hereby certify that under the requirements of P.A.74, Michigan P.A. of 1970, the corner points mentioned in lines 1 and 2 above were in conformance with the regulations and rules therefore as required in the current manual of survey instructions of the United States Department of the Interior, Bureau of Land Management of by a decree of a Court of Law and/or that the corner points mentioned in lines 3, 4, and 5 above were in conformance with the rules of the Michigan Board of Land Surveyors or by a Decree of a Court of Law; established, re-established, monumented, recovered, found as expressed below.

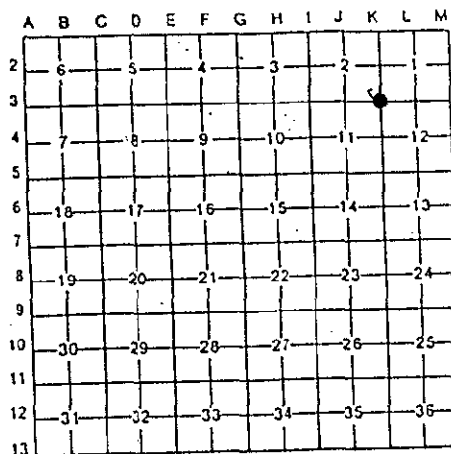

NOTE: Not more than 4 corners, all in the same town and range, may be recorded on this certificate

A. Description of original monument and accessories and/or restoration:

Set post Corner of Sections 1, 2, 11, & 12

Date	Location	Notes	Monument	Witnesses
01/24/1825	GLO (Brookfield)	Fld. Notes	Set Original Corner	1) 36" Beech S46 1/2E 23 links(15.18') 2) 24" Beech S30EW 40 links(26.4')
August 1957	D.C.P. 3165	Resurvey	Reset with Ford Axle	3) T.P. S00W 22.36' 4) 26" Walnut N45E 55.14' 5) 16" Ash S75E 79.23'
8/1/1972	Donald 14698 Olmstead	Boundary	Monument (Box?)	no witnesses
5/23/75	Donald 14698 Olmstead	Boundary	Monument (Box?)	no witnesses

B Description of corner evidence found and/or method applied in restoring or reestablishing corner:

In 1996 LSC found a Boat spike in a Monument Box 0.50' below road surface 1.40' South of centerline marking at intersection of Territorial and Gilbert Roads, one (1) recorded witnessess was found. LSC's measured distance's (2635.82 & 2645.22, 1996) checked proportionatly with GLO (2636.04 & 2640.00, 1825).

C Description of monument for corner and accessories established to perpetuate locating the position of the corner:

Set 1/2" Rebar with Remon Cap in Mon Box, established Three (3) additional witnesses

4) 24" Walnut	N50E	54.97' to nail/washer in W side.
6) SE Cor. cnoc.Fndn (Hsc # 7980)	N40W	97.65'
7) S 1/4 Cor. Sec. 2 T8-9S, R2W	S 89 deg. 27 min. 20 sec. W	2635.82
8) S 1/4 Cor. Sec. 1 T8-9S, R2W	S 89 deg. 24 min. 23 sec. E	2645.22

It is our opinion that this represents the best evidence of the position of the original corner.

Signed by R. T. Tietsema Date DEC 20 1996  
Surveyor's Michigan License No. 20712

