

118875

RECORDED

HILLSDALE CO. MICH.

'97 JAN 13 AM 11 57

ACCEPTED BY THE HILLSDALE COUNTY SURVEY PEER GROUP AS THE OFFICIAL CORNER UNDER MICHIGAN PUBLIC ACT 348 OF 1990 AT A MEETING HELD ON [Signature] AL RINGENBERG, CO. REP.

REMONUMENTATION LAND CORNER RECORDATION CERTIFICATE Filing Requirement of Act 74, Mich. P.A. 1970


Judy VanZandt REG. OF DEEDS

Table with columns: For corners in (HILLSDALE county), Located In, Corner Code #. Rows include Public Land Survey, Property Controlling in Section, and Miscellaneous Property in Sec.

Register of Deeds Stamp & File Number

4. Lot No. Recorded Plat
5. Private Claims

I, R.T. Tietsema, in a field survey on JUNE 20, 1996, do hereby certify that under the requirements of P.A.74, Michigan P.A. of 1970, the corner points mentioned in lines 1 and 2 above were in conformance with the regulations and rules therefore as required in the current manual of survey instructions of the United States Department of the Interior, Bureau of Land Management...

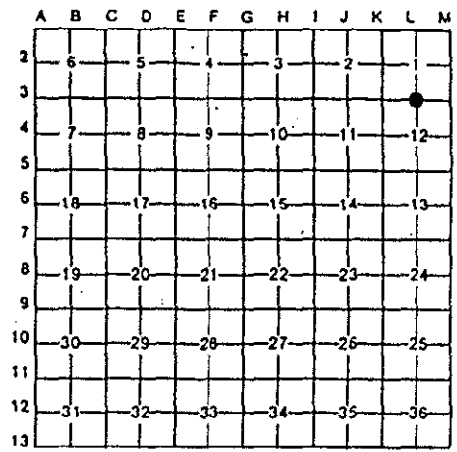

NOTE: Not more than 4 corners, all in the same town and range, may be recorded on this certificate

A. Description of original monument and accessories and/or restoration:

Set post Corner between Sections 1 & 12

Table with columns: Date, Location, Notes, Monument Description, Measurements. Includes entries for 12/26/1825 and August 1957.

3. Description of corner evidence found and/or method applied in restoring or reestablishing corner:

in June 1996, LSC could not find corner or its accessories, set corner half way between and on line with found corners K-3 and M-3.

B. Description of monument for corner and accessories established to perpetuate locating the position of the corner:

set 1/2" Rebar with Remon Cap 1.80' South of centerline of ditch, established four (4) witnesses.

- 5) Power Pole East 156.95' to P.K. on East Side of pole.
5) 6" Cherry S10W 57.72' to P.K. on East side.
7) CL Territorial S00E 20.35'
3) CL Ditch N00W 1.80'

SURVEY & REMONUMENTATION

MAY 16 1997

COMMISSION

is our opinion that this represents a careful and faithful reestablishment of the position of the original corner.

Signed by [Signature] Date DEC 20 1996
Surveyor's Michigan License No. 20712