

ACCEPTED BY THE HILLSDALE COUNTY SURVEY PEER GROUP AS THE OFFICIAL CORNER UNDER MICHIGAN PUBLIC ACT 345 OF 1990 AT A MEETING HELD ON 12/19/96 AL RINGENBERG, CO. REC.

LIBER 3 PAGE 118
REMONUMENTATION

118385

RECORDED
HILLSDALE CO. MICH.

'96 DEC 19 PM 2 19

LAND CORNER RECORDATION CERTIFICATE
Filing Requirement of Act 74, Mich. P.A. 1970

Judy VanZandt
REC. OF DEEDS

For corners in
HILLSDALE
(County)

Located In: Corner Code =#

1. Public Land Survey	T	9S	R	3W	A-3 B-3
	T		R		
	T		R		
	T		R		
2. Property Controlling in Section	S		T	R	
	S		T	R	
3. Miscellaneous Property in Sec.	S		T	R	
	S		T	R	

Register of Deeds Stamp & File Number

4. Lot No. _____, Recorded Plat _____
5. Private Claims _____

	A	B	C	D	E	F	G	H	I	J	K	L	M
2	6		5		4		3		2				
3													
4	7		8		9		10		11		12		
5													
6	18		17		16		15		14		13		
7													
8	19		20		21		22		23		24		
9													
10	30		29		28		27		26		25		
11													
12	31		32		33		34		35		36		
13													

I, JEFFREY BIESZK, in a field survey on 10 DECEMBER, 1996

do hereby certify that under requirements of P.A. 74, Michigan P.A. of 1970, the corner points mentioned in lines 1 and 2 above were in conformance with regulations and rules therefore as required in the current manual of survey instructions of the United States Department of the Interior, Bureau of Land Management or by a decree of a Court of Law and/or that the corner points mentioned in lines 3, 4 and 5 above were in conformance with the rules of the Michigan Board of Land Surveyors or by a Decree of a Court of Law; established, re-established, monumented, re-monumented, recovered, found as expressed below:

NOTE: Not more than 4 corners, all in the same town and range, may be recorded on this certificate.

A. Description of original monument and accessories and/or subsequent restoration:

A-3
1837 GLO
POST
18 BEECH N75E 29 lks
15 BEECH S34.5E 52 lks
204 lks NORTH OF M-3, T93-R4W

MARKS
STONE & BRICK
NO WITNESS

B-3
1837 GLO
POST
20 BEECH N80E 29 lks
14" BEECH S03W 4 lks

MARK
REESTABLISH CORNER
SET STONE & EARTHEN
12 SUG N04.5W 45.25 lks
12 B. WALNUT S48.5W 32 lks

B. Description of corner evidence found and/or method applied in restoring or reestablishing corner:

A-3: GEORGE MARK SET AND FOUND CORNER IN A NUMBER OF HIS SURVEYS. I DID NOT FIND STONE OR BRICK, BUT DID FIND A PINCH PIPE ON THE NORTH EDGE OF ROAD. IRON FITS TO THE OCCUPATION TO THE NORTH AND IT IS 204 LINKS NORTH OF INTERSECTION OF ROAD SOUTH AND WEST. ALSO MEASURED FROM THIS CORNER TO B-3 AND WESTERLY EIGHTH LINE AND THESE MEASUREMENT FITS WHAT MARKS MEASURED. ACCEPTED AS THE BEST AVAILABLE EVIDENCE OF THE POSITION OF THE ORIGINAL CORNER.

B-3: GEORGE MARK REESTABLISHED CORNER AND SET STONE AND EARTHEN. DID NOT FIND STONE, BUT TOOK MEASUREMENTS FROM THIS CORNER TO A-3 AND WESTERLY EIGHTH LINE AND C-3. WHERE THIS CORNER WAS CENTERLINE OF ROAD AND FENCE TO SOUTH. THE MEASUREMENTS FITS WHAT MARKS MEASURED IN HIS SURVEYS. ACCEPTED AS THE BEST AVAILABLE EVIDENCE OF THE POSITION OF THE ORIGINAL CORNER.

C. Description of monument for corner and accessories established to perpetuate locating the position of the corner:


A-3:
SET 5/8" x 36" REBAR W/CAP
NAIL 20" APPLE NORTH 61.16'
STEEL CORNER POST NORTH 14.24'
NW COR. CONC HEADWALL S45E 65.54'
SW COR. CONC HEADWALL S10E 50.73'

B-3:
SET 5/8" x 36" REBAR W/CAP
NAIL & TAG 60" MAPLE NORTH 30.62'
CENTER OF RISER N55W 51.95'
NAIL & TAG 12" MAPLE S15E 38.25'
NAIL & TAG 14" MAPLE S45W 57.86'

SURVEY &
REMONUMENTATION

MAY 16 1997

COMMISSION

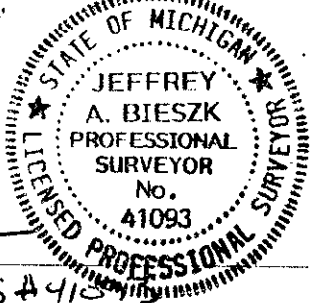

Signed by *[Signature]*
Surveyor's Michigan License No. PS A 410

Date 18 DECEMBER 1996