

ACCEPTED BY THE HILLSDALE COUNTY SURVEY PEER GROUP AS THE OFFICIAL CORNER UNDER MICHIGAN PUBLIC ACT 345 OF 1996 AT A MEETING HELD ON [Signature] AL RINGENBERG CO. REC.

LIBER 3 PAGE 120
REMONUMENTATION

118387

RECORDED
HILLSDALE CO. MICH.

LAND CORNER RECORDATION CERTIFICATE
Filing Requirement of Act 74, Mich. P.A. 1970

'96 DEC 19 PM 2 19

For corners in


HILLSDALE (County)	Located In:	Corner Code #/
1. Public Land Survey	T 9S R 3W	D-3, E-3
	T R	
	T R	
	T R	
2. Property Controlling in Section	S T R	
	S T R	
3. Miscellaneous Property in Sec.	S T R	
	S T R	

Jeffrey W. Bieszk
REG. OF DEEDS

Register of Deeds Stamp & File Number

4. Lot No. _____, Recorded Plat _____
5. Private Claims _____

I, JEFFREY BIESZK, in a field survey on 10 DECEMBER, 1996, do hereby certify that under requirements of P.A. 74, Michigan P.A. of 1970, the corner points mentioned in lines 1 and 2 above were in conformance with regulations and rules therefore as required in the current manual of survey instructions of the United States Department of the Interior, Bureau of Land Management or by a decree of a Court of Law and/or that the corner points mentioned in lines 3, 4 and 5 above were in conformance with the rules of the Michigan Board of Land Surveyors or by a Decree of a Court of Law; established, re-established, monumented, re-monumented, recovered, found as expressed below:

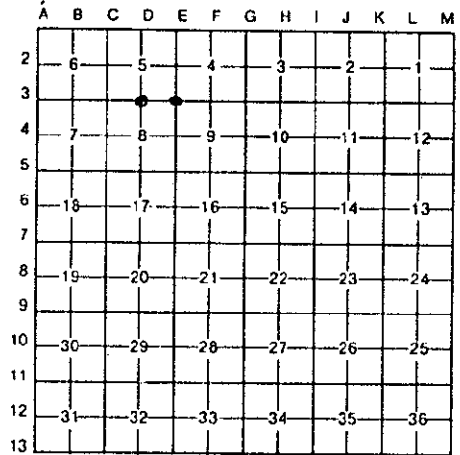

NOTE: Not more than 4 corners, all in the same town and range, may be recorded on this certificate.

A. Description of original monument and accessories and/or subsequent restoration:

<u>D-3:</u> 1837 GLO POST 9 BEECH S51E 15 lks 8 BEECH S20.5W 15 lks	<u>E-3:</u> 1837 GLO POST 14 R. OAK N80E 21 lks 6 W. OAK S38.5E 15 lks	<u>DONALD OLMSTEAD</u> SET R.R. SPIKE 18" HICKORY NW 40.15' 24" OAK NE 46.25' LCRC LI P389
<u>GEORGE MARK</u> STONE 14 ELM N24.5E 38 lks 6 ELM N62.75W 44 lks	<u>GEORGE MARK</u> DOES NOT SAY WHAT IS FOUND OR SET	

B. Description of corner evidence found and/or method applied in restoring or reestablishing corner:


D-3: GEORGE MARK SET STONE AT CORNER IN HIS SURVEYS AND WITNESSED IT. KELLER FOUND IRON AND WITNESSED THIS AS THE CORNER. FROM MEASUREMENTS TAKEN FROM D-3 TO E-3 AND FROM D-3 TO C-3 THIS CORNER WAS NEAR THE SPLIT OF THE MILE AND FITS THE OCCUPATION TO THE SOUTH. ACCEPTED AS THE BEST AVAILABLE EVIDENCE OF THE POSITION OF THE ORIGINAL CORNER.

E-3: DONALD OLMSTEAD SET R.R. SPIKE FROM STATE SURVEY CREW NOTES BASED ON F-3 AND A STONE AT THE SOUTHWEST CORNER OF SECTION 9. THIS CORNER FITS OCCUPATION IN ALL DIRECTIONS. ACCEPTED AS A CAREFUL AND FAITHFUL PERPETUATION OF THE POSITION OF THE ORIGINAL CORNER.

C. Description of monument for corner and accessories established to perpetuate locating the position of the corner:

D-3:
SET 5/8" x 36" REBAR W/CAP IN MON BOX
FNC POST N25W 24.20'
FNC POST N60E 84.25'
NAIL & TAG 8" ELM S15W 43.75'
MAIL BOX POST S60E 64.32'

E-3:
SET 5/8" x 36" REBAR W/CAP IN MON BOX
STOP SIGN POST S15E 53.96'
CENTER OF RISER S35W 46.00'
NAIL & TAG 36" OAK N25E 46.81'
NAIL & TAG 30" HICKORY N30W 40.63'

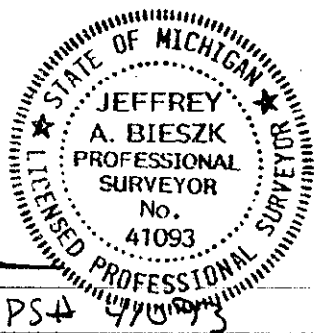

SURVEY &
REMONUMENTATION

MAY 16 1997

COMMISSION

Signed by [Signature] Date 10 DECEMBER 1996
