



118390

LIBER 3 PAGE 123
REMONUMENTATION

RECORDED
HILLSDALE CO. MICH.

LAND CORNER RECORDATION CERTIFICATE
Filing Requirement of Act 74, Mich. P.A. 1970

'96 DEC 19 PM 2 19

Judy VanZandt
REG. OF DEEDS

For corners in

HILLSDALE
(County)

Located In:

Corner Code #

1. Public Land Survey	T	9S	R	3W	J-3, K-3
	T		R		
	T		R		
	T		R		
2. Property Controlling in Section	S		T	R	
	S		T	R	
3. Miscellaneous Property in Sec.	S		T	R	
	S		T	R	

Register of Deeds Stamp & File Number

4. Lot No. _____, Recorded Plat _____
5. Private Claims _____

A	B	C	D	E	F	G	H	I	J	K	L	M
2	6	5	4	3	2	1						
3												
4	7	8	9	10	11	12						
5												
6	18	17	16	15	14	13						
7												
8	19	20	21	22	23	24						
9												
10	30	29	28	27	26	25						
11												
12	31	32	33	34	35	36						
13												

I, JEFFREY BIESZK, in a field survey on 10 DECEMBER, 1996, do hereby certify that under requirements of P.A. 74, Michigan P.A. of 1970, the corner points mentioned in lines 1 and 2 above were in conformance with regulations and rules therefore as required in the current manual of survey instructions of the United States Department of the Interior, Bureau of Land Management or by a decree of a Court of Law and/or that the corner points mentioned in lines 3, 4 and 5 above were in conformance with the rules of the Michigan Board of Land Surveyors or by a Decree of a Court of Law; established, re-established, monumented, re-monumented, recovered, found as expressed below:

NOTE: Not more than 4 corners, all in the same town and range, may be recorded on this certificate.

A. Description of original monument and accessories and/or subsequent restoration:

J-3:
1837 GLO
POST
15 BEECH N01W 10 lks
5 W. ASH S65.33E 12 lks

K-3:
1837 GLO
POST
10 BEECH S01E 28 lks
12 BEECH S51.5E 18 lks

B. Description of corner evidence found and/or method applied in restoring or reestablishing corner:

J-3: FOUND 3/4" PIPE IN MONUMENT BOX 1 FOOT SOUTH CENTERLINE OF ROAD EAST-WEST AND 5.5 FEET WEST CENTERLINE ROAD TO SOUTH, FITS FENCE TO THE NORTH. I-3 TO J-3 AND K-3 IS ON LINE WITH EACH OTHER AND IS ABOUT 3 FEET FROM A SPLIT. NO OTHER WITNESSES FOUND. ACCEPTED AS THE BEST AVAILABLE EVIDENCE OF THE POSITION OF THE CORNER.


K-3: FOUND R.R. SPIKE AT INTERSECTION OF THE ROADS. I-3 TO J-3 AND K-3 IS ON LINE WITH EACH OTHER AND IS ABOUT 3 FEET FROM A SPLIT. ACCEPTED AS THE BEST AVAILABLE EVIDENCE OF THE POSITION OF THE CORNER.

SURVEY &
REMONUMENTATION
MAY 16 1997
COMMISSION

C. Description of monument for corner and accessories established to perpetuate locating the position of the corner:

J-3:
SET 5/8" x 36" REBAR IN MON BOX
NAIL & TAG FENCE POST NORTH 29.37'
NAIL & TAG 30" MAPLE S40W 84.00'
NAIL & TAG 40" OAK S40E 79.15'
CENTER RISER N35E 60.89'

K-3:
SET 5/8" x 36" REBAR IN MON BOX
CENTER RISER N50E 50.38'
STOP SIGN POST S15E 45.10'
NAIL & TAG DBL MAPLE S25W 113.30'
SE CORNER BLDG N45W 84.38'

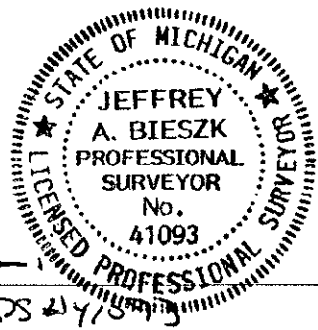

Signed by [Signature] Date 12 DECEMBER 1996
