REMONUMENTATION

DEC 17 1998

SECTION

LAND CORNER RECORDATION CERTIFICATE

Filing Requirement of Act 74, Mich. P.A. 1970

Liber 9 Page 337

For corners in

INGHAM COUNTY

Bunker Hill Township

		Located In:	Corner Code #
1. Public Land Survey		T 1N R 1E	A-2
		T___ R___	
		T___ R___	
		T___ R___	
2. Property Controlling	S___	T___ R___	
In Section	S___	T___ R___	
3. Miscellaneous	S___	T___ R___	
Property in Sec.	S___	T___ R___	

FILED

98004940Z
09/29/1998 10:51:36
REGISTER OF DEEDS
Paula Johnson
INGHAM COUNTY,MI

Register of Deeds Stamp & File Number

4. Lot No. _____ , Recorded Plat _____

5. Private Claims _____

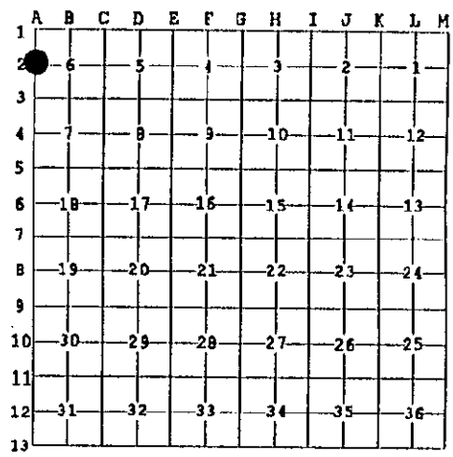

I, Maurice H. Mahieu, in a field survey on July 28, 1998 do hereby state that under requirements of P.A. 74, Michigan P.A. of 1970, the corner points mentioned in lines 1 and 2 above were in conformance with regulations and rules therefore as required in the current manual of survey instructions of the United States Department of the Interior, Bureau of Land Management or by a decree of a Court of Law and /or that the corner points mentioned in lines 3, 4 and 5 above were in conformance with the rules of the Michigan Board of Land Surveyors or by a Decree of a Court of Law; established, re-established, monumented, recovered, found as expressed below:

NOTE: Not more than 2 corners, all in the same town and range, may be recorded on this certificate.

A. Description of original monument and accessories and/or subsequent restoration:

1. Corner not set in original government survey.

2. L.C.R.C. recorded in liber 6, page 105 on November 13, 1980 by Ronnie M. Lester R.L.S. #18998. Lester excavated an 8' x 6' x 1.5' hole on the centerline of Kelly Road and on a fenceline east. No physical evidence was uncovered. Set 4" x 36" concrete monument with 1/2" x 38" rerod and cap #18998 on line between M-1 and M-2 and on line with old fence east. Measured north to A-1 3188.8'; measured south to A-3 2655.68'; measured south to M-2 747.85'; measured north to M-1 1899.05'. Witnesses: Nail and tag #18998 east side 14" oak NNW 60.78'; Nail and tag #18998 east side 10" oak SW 65.42'; Nail and tag #18998 south side 20" Maple NE 38.86'; Nail and tag #18998 south side 46" oak east 21.55'.

B. Description of corner evidence found and/or method applied in restoring or reestablishing corner:

Found 1/2" rerod and cap #18998 Ronnie Lester P.S., in concrete monument in centerline Kelly rd. And on fenceline to east extended. Top of capped rerod was .5' below road surface. Found witnesses: Nail and tag #39075 Karol Cerovec P.S., East side 16" Oak N 30 W 60.64'; Nail and tag #39075 E. side 14" Oak S 25 W 65.52'; Nail and tag #39075 S. side 24" Maple N 40 E 38.66'; Nail and tag #18998 SW side 40" Oak S 85 E 21.47'. Site was excavated by Ronnie M. Lester in 1980, and therefore no excavation was deemed necessary at this time. Accepted location as set by Ronnie Lester as the best location of an obliterated corner. Affixed an aluminum p.a. 345 cap #28414 over Lester's cap and re-witnessed.

C. Description of monument for corner and accessories established to perpetuate locating the position of the corner:

Found 1/2" rerod and cap #18998 in a 4" concrete monument and affixed an aluminum P.A. 345 cap #28414 over it.
Witnessed by:
Found Nail and Tag #39075 East side 16" Oak, N 30° W 60.64'
Found Nail and Tag #39075 East side 14" Oak S 25° W 65.52'
Found Nail and Tag #39075 South side 24" Maple N 40° E 38.66'
Found Nail and Tag #18998 Southwest side 40" Oak S 85° E 21.47'

STATE OF MICHIGAN
MAURICE H. MAHIEU
PROFESSIONAL SURVEYOR
No. 28414
LICENSED PROFESSIONAL SURVEYOR

Signed by Maurice H Mahieu Date 9-17-98

Surveyor's Michigan License No. 28414

FORM APPROVED BY MICHIGAN STATE BOARD OF PROFESSIONAL SURVEYORS, JAN. 28, 1971
REVISED MAY 14, 1975
REVISED JAN., 1983
REVISED OCT., 1995

P.A. 345 INGHAM COUNTY
PEER APPROVED 8/11/98 MC