SURVEY & REMONUMENTATION

DEC 17 1998

SECTION

LAND CORNER RECORDATION CERTIFICATE

Filing Requirement of Act 74, Mich. P.A. 1970

Liber 9 Page 444

For corners in BUNKERHILL TOWNSHIP

INGHAM COUNTY

		Located In:	Corner Code #
1. Public Land Survey		T 1N R 1E	A-3
		T___ R___	
		T___ R___	
		T___ R___	
2. Property Controlling	S___	T___ R___	
in Section	S___	T___ R___	
3. Miscellaneous	S___	T___ R___	
Property in Sec.	S___	T___ R___	

FILED

980061037
12/01/1998 10:44:43
REGISTER OF DEEDS
Paula Johnson
INGHAM COUNTY,MI

Register of Deeds Stamp & File Number

4. Lot No. _____, Recorded Plat _____
5. Private Claims _____

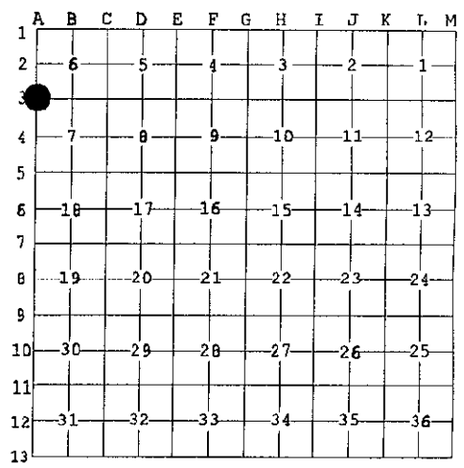

I, Maurice H. Mahieu, in a field survey on September 4, 1998 and October 8, 1998, do hereby state that under requirements of P.A. 74, Michigan P.A. of 1970, the corner points mentioned in lines 1 and 2 above were in conformance with regulations and rules therefore as required in the current manual of survey instructions of the United States Department of the Interior, Bureau of Land Management or by a decree of a Court of Law and /or that the corner points mentioned in lines 3, 4 and 5 above were in conformance with the rules of the Michigan Board of Land Surveyors or by a Decree of a Court of Law; established, re-established, monumented, recovered, found as expressed below:

NOTE: Not more than 2 corners, all in the same town and range, may be recorded on this certificate.

A. Description of original monument and accessories and/or subsequent restoration:

1. Original corner set by Joseph Wampler D.S. during February, 1826 "33.69 Intersect Meridian; Tam. 10 S 17E 5 DO. N 32 E 4".

2. An Act 132 survey recorded in Liber 3, Page 604 by Austin C. Williams R.L.S. #21275 on November 17, 1978. Monumentation not described. Witnesses: Nail and Tag in 12" Oak, West 29.25'; Nail and Tag in 8" Elm N 20° W 55.85'; Nail and Tag in 8" Elm S 15° E 45.28'. Corner lies 5845.69' South of A-1 as measured by Williams.

3. LCRC recorded in Liber 5, Page 67 by Austin C. Williams R.L.S. #21275 on November 17, 1978. "Original monument and accessories obliterated. Set ½" iron bar with identification cap by proportionate measurement North and South and in line with corners of Section 1, T1N, R1W. Measurements are in close accord with GLO records." Witnesses same as in #2.

B. Description of corner evidence found and/or method applied in restoring or reestablishing corner:

Found ½" x 20" smooth iron rod +/-1.5' West of the centerline of Kelly Road (gravel) and 2.16' below gravel surface. No visible occupation lines East or West; area wooded and swampy. Corner was found to be +/- 2655.68' South of A-2 during a rough traverse. Found witness: Nail and ribbon in North side of an 18" Oak N 85° W 29.04'. Excavated a 4' x 3' x 4' deep area and found nothing. Measured the Standard Township Line and found ½" rod to be 5.77 feet West of Standard Line. Set 3/4" x 24" iron rod with cap due as an amended corner East 5.77 feet from found ½" rod. Measured 2655.78 feet North to A-2 (L9, P337); Corner falls 749.48 feet North of M-3 Leslie Township (L9, P284). Accepted North-South location of Williams Corner set amended corner.

C. Description of monument for corner and accessories established to perpetuate locating the position of the corner:

WILLIAMS CLOSING CORNER
Found 1/2" iron and replaced with 3/4" x 24" iron with aluminum P.A. 345 cap #28414. Witnesses:
Nail and Tag #28414 East side 18" Maple N 30° W 44.70'
Nail and Tag #28414 North side 18" Oak N 85° W 29.04'
Nail and Tag #28414 West side 12" Maple N 40° E 57.77'
Nail and Tag #28414 West side 12" Oak S 30° E 58.14'

AMENDED CORNER
Set 3/4" x 24" iron rod with aluminum cap #28414 on Standard Line. Witnessed by:
Nail & Tag #28414 East side 18" Maple N36°W 47.85'
Nail & Tag #28414 North side 18" Oak N86°W 34.79'
Nail & Tag #28414 West side 12" Maple N35°E 54.24'
Nail & Tag #28414 West side 12" Oak S25°E 55.48'

Signed by Maurice H Mahieu Date 11-18-98

Surveyor's Michigan License No. 28414

STATE OF MICHIGAN
MAURICE H. MAHIEU
PROFESSIONAL SURVEYOR
No. 28414
LICENSED PROFESSIONAL SURVEYOR

FORM APPROVED BY MICHIGAN STATE BOARD OF PROFESSIONAL SURVEYORS, JAN. 28, 1971
REVISED MAY 14,1975
REVISED JAN., 1983
REVISED OCT., 1995

P.A. 345 INGHAM COUNTY
PEER APPROVED 11/4/98 M