

DEC 17 1998

SECTION

LAND CORNER RECORDATION CERTIFICATE  
Filing Requirement of Act 74, Mich. P.A. 1970

Liber 9 Page 340

For corners in BUNKERHILL TOWNSHIP

INGHAM COUNTY	Located In:	Corner Code #
1. Public Land Survey	T <u>1N</u> R <u>1E</u>	<u>C-2</u>
	T _____ R _____	_____
	T _____ R _____	_____
	T _____ R _____	_____
2. Property Controlling in Section	S _____ T _____ R _____	_____
	S _____ T _____ R _____	_____
3. Miscellaneous Property in Sec.	S _____ T _____ R _____	_____
	S _____ T _____ R _____	_____

FILED

980049404  
09/29/1998 10:51:40  
REGISTER OF DEEDS  
Paula Johnson  
INGHAM COUNTY, MI

Register of Deeds Stamp & File Number

4. Lot No. \_\_\_\_\_, Recorded Plat \_\_\_\_\_  
5. Private Claims \_\_\_\_\_

I, Maurice H. Mahieu, in a field survey on July 29, 1998, do hereby state that under requirements of P.A. 74, Michigan P.A. of 1970, the corner points mentioned in lines 1 and 2 above were in conformance with regulations and rules therefore as required in the current manual of survey instructions of the United States Department of the Interior, Bureau of Land Management or by a decree of a Court of Law and /or that the corner points mentioned in lines 3, 4 and 5 above were in conformance with the rules of the Michigan Board of Land Surveyors or by a Decree of a Court of Law; established, re-established, monumented, recovered, found as expressed below:

NOTE: Not more than 2 corners, all in the same town and range, may be recorded on this certificate.

A. Description of original monument and accessories and/or subsequent restoration:

1. Original corner set by Joseph Wampler D.S. on February 8, 1826 at a distance of 40.00 chains. "Set 1/2 Mile Post; B.O. 18 N 16 W 41; W.O. 11 N 74 E 62".
2. Additional notes to Wampler's: "Tile set for corner by A.P. Drake."
3. An Act 132 survey recorded in Liber 2, Page 1133 on May 25, 1977 by Austin C. Williams RLS #21275. Monumentation not described. Witnesses: Street sign N 45° E 41.20'; Nail in 30" Oak N 35° W 47.01'; Steel fence post W 31.38'.
4. LCRC recorded in Liber 4, Page 85 on September 16, 1977 by Lavern J. Hendryx RLS #3276. "#4 Iron." Witnesses: Centerline steel fence post W 29.25'; Spike in 24" Ash NNW 46.26'; Spike in 32" Oak SSW 68.40'.

(Continued On Back)

B. Description of corner evidence found and/or method applied in restoring or reestablishing corner:

Found 2 1/4" long carriage bolt with a 1" diameter head on intersection centerline Meridian Road and centerline Ewers Road and on fence line West. Found Nail and Tag #39075 Karol Cerovec, P.S. North side Wood Post S 55° E (Post struck by automobile and twisted so that tag is now on SE side of post and therefore not easily accurately measurable) roughly 30'. Found Nail & Tag #18998, Ronnie Lester P.S., East side 42" Oak, S 30° W 67.49'. Excavated a 2' x 2' x 3' area. Found a 0.65' long squared spike with a .05' diameter railroad spike-like head on its side ±1' under the surface. Spike was bent and twisted. Found nothing else. Accepted position of bolt and spike as best location of an obliterated corner. Replaced carriage bolt with 3/4" iron rod and aluminum P.A. 345 Cap #28414 and set monument box around. Corner lies 3156.03' from C-1 and 2646.51' from C-3 as measured by Ronnie Lester P.S. #18998.

C. Description of monument for corner and accessories established to perpetuate locating the position of the corner:

Found 2 1/4" long, 1" headed carriage bolt and replaced with 3/4" iron with aluminum P.A. 345 cap #28414.


Witnessed by:

- Nail and Tag #18998 East side 42" Oak S 30° W 67.49'.
- Nail and Tag #28414 South side 18" Maple N 65° E 124.57'
- Nail and Tag #28414 South side 4' Maple N 45° E 61.24'
- Nail and Tag #28414 East side 16" Walnut N 25° W 73.22'

Signed by Maurice H. Mahieu

Date 9-17-98

Surveyor's Michigan License No. 28414

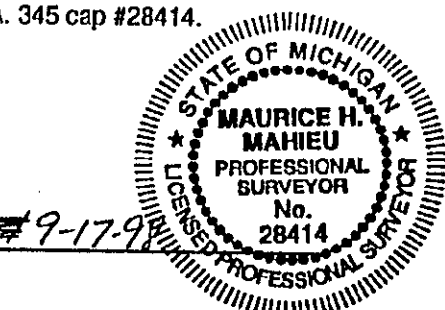

A. (CONTINUED)

5. An Act 132 survey recorded in Liber 3, Page 353 on March 13, 1978 by Austin C. Williams RLS #21275. Monumentation and witnesses not specifically described; corner referenced to liber 4, page 85 (A. 4. above) on certificate of survey.
6. An Act 132 survey recorded in Liber 3, Page 804 on March 19, 1979 by Ron Helsel RLS #18994. Monumentation and witnesses not specifically described; corner referenced to liber 4, page 85 (A. 4. above) on certificate of survey.

CHECK BY &  
PERMONUMENTATION

DEC 17 1998

SECTION

Rcpt No	97035
CRSR	9.00
MSSR	2.00
Total	11.00

79