

SURVEY & REMONUMENTATION
APR 10 1995
COMMISSION

Nov 22 11 47 AM '94

LAND CORNER RECORDATION CERTIFICATE
 Filing Requirement of Act 74, Mich. P.A. 1970
BUNKER HILL

REGISTER OF DEEDS
David Johnson
 INGHAM COUNTY, MICH.

For corners in
INGHAM
 (County)

Located In: _____ Corner Code: ##

- 1. Public Land Survey T 1 N - R 1 E - C-7
- 2. Property Controlling in Section S _____ T _____ R _____
- 3. Miscellaneous Property in Sec. S _____ T _____ R _____
- 4. Lot No. _____, Recorded Plat _____
- 5. Private Claims _____

Register of Deeds Stamp & File Number

	A	B	C	D	E	F	G	H	I	J	K	L	M
2	6	5	4	3	2	1							
3													
4	7	8	9	10	11	12							
5													
6	13	17	16	15	14	13							
7													
8	19	20	21	22	23	24							
9													
10	30	29	28	27	26	25							
11													
12	31	32	33	34	35	36							
13													

Maurice H. Mahieu in a field survey on October 10, 1994, do hereby certify that under requirements of P.A. 74, Michigan P.A. of 1970, the corner points mentioned in lines 1 and 2 above were in conformance with regulations and rules therefore as required in the current manual of survey instructions of the United States Department of the Interior, Bureau of Land Management or by a decree of a Court of Law and/or that the corner points mentioned in lines 3, 4 and 5 above were in conformance with the rules of the Michigan Board of Land Surveyors or by a Decree of a Court of Law; established, re-established, monumented, re-monumented, recovered, found as expressed below:


NOTE: Not more than 4 corners, all in the same town and range, may be recorded on this certificate.

- A. Description of original monument and accessories and/or subsequent restoration:
 - 1. Original GLO survey completed by Joseph Wampler between January 30 and February 6, 1826. Set a post at the corner of the section at a distance of 80 chains, witnessed by:
 - 12" Maple N 77 1/2° E 27 1/2 links
 - 18" Maple S 62° E 48 links
 - 2. Corner noted in field survey done by A. Jackson, County Surveyor, November 28, 1845 (L-1, P-79) same witnesses as in GLO survey.

B. Description of corner evidence found and/or method applied in restoring ^(Over) or reestablishing corner:
 Found 1" Iron Rod in Monument Box at intersection of centerline of Kinneville Road and extension centerline of Meridian Road, north. Found USGS marker witness as called for in A-5. All other witnesses gone. Removed rod and dug down in monument box. Found nothing. Excavated to 3 foot down and around and to west of monument box. Excavated west due to witness differences between Hickory in A-3 and witnesses in A-5 and A-6. Found nothing. Accepted position of 1" rod as location of corner based on excavation that did not produce any other evidence of a corner.

C. Description of monument for corner and accessories established to perpetuate locating the position of the corner:

3/4" Rod w/cap P.A. 345, P.S. #28414 Set in Location of 1" Rod in Monument Box
 Nail and Tag West Side Utility Pole, N 04° E 159.21'
 Nail and Tag West Side Guy Pole, N 04° W 159.54'
 Nail and Tag North Side Fence Post, S 00° W 33.54'
 NW Corner House #4010, S 30° E 85.75'

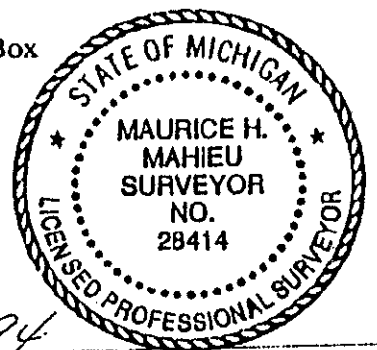

Signed by Maurice H. Mahieu Date 11-9-94
 Surveyor's Michigan License No. #28414

A. (Continued)

3. Ingham County Road Commission identified corner by an iron brick. Witnessed by:
16" Hickory 141.9' WNW
12" Hickory 66.0' ESE
4. Ingham County Grid Map dated January 1, 1972, calls for a 5/8" Round Iron (1971) witnessed by:
20" Hickory ESE 62.74', Corner Post S 24.23 feet, T.P. SSW 20.75'
5. Recorded Act 74 L.C.R.C. August 21, 1972, by Oscar Boss (L-5, P-6).
Found 3/4" rod at intersection of roads. Witnessed by:
P.K. Found North side 20" Hickory, S 76° E 62.71'
Center top USGS Marker, S 20° E 19.05'
Nail East side Telephone Pole, S 21° W 20.67'
6. Recorded Act 74 L.C.R.C. June 1980 by Ronald W. Keller, Land Surveyor (L-6, P-64).
Found 1" Iron Rod in centerline roads North, East, and West in line with fence going South.
Witnessed by:
Telephone Pole, S 21° W 20.62'
18" Hickory, S 74° E 62.73'
West leg of sign, N 02° E 29.61'