

REMONUMENTATION

DEC 12 1997

COMMISSION

LAND CORNER RECORDATION CERTIFICATE
Filing Requirement of Act 74, Mich. P.A. 1970

Liber 9 Page 209

For corners in

INGHAM
(County)
BUNKERHILL TOWNSHIP

Located In:	Corner Code #
1. Public Land Survey	T <u>1N</u> R <u>1E</u> <u>K-1</u>
	T _____ R _____
	T _____ R _____
	T _____ R _____
2. Property Controlling in Section	S _____ T _____ R _____
	S _____ T _____ R _____
3. Miscellaneous Property in Sec.	S _____ T _____ R _____
	S _____ T _____ R _____

FILED

970029269
08/06/1997 09:00:11
REGISTER OF DEEDS
Paula Johnson
INGHAM COUNTY, MI

Register of Deeds Stamp & File Number

4. Lot No. _____, Recorded Plat _____
5. Private Claims _____

I, DAVID R. LOHR, in a field survey on 3/28, 19 97 do hereby state that under requirements of P.A. 74, Michigan P.A. of 1970, the corner points mentioned in lines 1 and 2 above were in conformance with regulations and rules therefore as required in the current manual of survey instructions of the United States Department of the Interior, Bureau of Land Management or by a decree of a Court of Law and/or that the corner points mentioned in lines 3, 4 and 5 above were in conformance with the rules of the Michigan Board of Land Surveyors or by a Decree of a Court of Law; established, re-established, monumented, recovered, found as expressed below:

NOTE: Not more than 2 corners, all in the same town and range, may be recorded on this certificate.

1	A	B	C	D	E	F	G	H	I	J	K	L
2		6		5		4		3		2		1
3												
4		7		8		9		10		11		12
5												
6		10		17		16		15		14		13
7												
8		19		20		21		22		23		24
9												
10		30		29		28		27		26		25
11												
12		31		32		33		34		35		36
13												

A. Description of original monument and accessories and/or subsequent restoration:

K-1: 1. CORNER SET BY JOSEPH WAMPLER, DEP SURVEYOR, IN FEB., 1826.
"INTERSECT. THE TOWNSHIP LINE 37 LKS EAST" (24.42')
WITNESSED BY: B.O. 11 S 63 W, 34 1/2 LKS (22.77')
" 9 S 60 E, 33 1/2 LKS (22.11')
"NEW" W. OAK 3 N 8 W, 51 LKS (33.66')
NOTES SHOW DISTANCE SOUTH OF 43.27 CH. (2855.82')

CONTINUED ON BACK

B. Description of corner evidence found and/or method applied in restoring or reestablishing corner:


K-1: SEARCHED AT APPARENT LOCATION OF CORNER AND FOUND 1/2" IRON, 10" DEEP, ON FENCE TO SOUTH, AS PER ITEM #A-7. CORNER FALLS 27 FT. NORTH OF 6" X 8" R.R. TIE ANCHOR POST. DID NOT EXCAVATE CORNER DUE TO PREVIOUS EXCAVATION OF 1977, (ITEM A-7. ACCEPTED 1/2" IRON AS CORNER AS PER TESTIMONY OF SURVEYOR BRYAN IN ITEM #A-7. REPLACED 1/2" IRON WITH STANDARD 3/4" X 24" REMON. BAR AND PA #345 CAP #30090. REVIEW OF TRAVERSE DATA FROM BRYAN SURVEY IN SECTION 36, INGHAM TOWNSHIP, JOB #90-B-29711, PLACES THIS CORNER 2641.82 FT. WEST OF L-1.

C. Description of monument for corner and accessories established to perpetuate locating the position of the corner:

K-1: SET STANDARD 3/4" X 24" REMON. BAR AND PA#345 CAP #30090 AT LOCATION OF 1/2" IRON: WITNESSED BY:
SET N&T #30090, E/S 12" CHERRY, AZ. 214-32-30, 55.90'
SET N&T #30090, S/S 36" OAK, AZ. 291-59-00, 62.15'
K-13 INGHAM, 3/4" REMON. BAR, AZ. 270-00-00, 27.05' (GLO=24.42')
SET N&T #30090, E/S 36" OAK, AZ. 309-50-30, 45.64'
FD. N&T #25832, S/S 48" OAK, AZ. 338-55-00, 25.75'

Signed by David R. Lohr
Surveyor's Michigan License No. 30090

Date 6-16-97

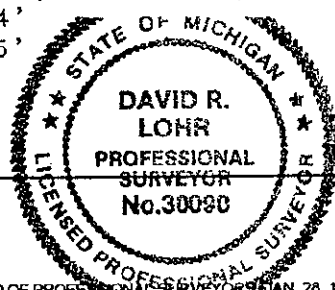

K-1: BUNKERHILL TOWNSHIP, PART A - CONTINUED

2. CORNER REFERENCED IN SURVEY BY A. JACKSON, CO. SURVEYOR, DATED MAY 20, 184 RECORDED IN BOOK 4, PAGE 116. (OLD VOL. 1, PG.117) NO MENTION OF MONUMENT OR WITNESSES.
3. CORNER REFERENCED IN SURVEY BY A.P.DRAKE, CO. SURVEYOR, DATED APRIL 16, 18 RECORDED IN BOOK 3, PAGE 31, (OLD VOL.3, PG. 172). "POST", WITNESSED BY:
W.O. 3, N 8 W, 51 LKS (33.66')

SURVEY SHOWS DISTANCE EAST TO L-1 OF 40.02 CH. (2641.32')
SURVEY SHOWS DISTANCE SOUTH TO K-2 OF 45.90 CH. (3029.40')

4. CORNER NOT REFERENCED ON INGHAM COUNTY GRID MAP, DATED JAN. 1969,
5. LCRC, BY OSCAR BOSS, RLS #13574, DATED 05/31/73, RECORDED IN LIBER 5, PAGE 10. "K-1:(ORIGINAL) UNKNOWN...1/2" IRON SET AT INTERSECTION OF ROAD AND FENCE LINE SOUTH." WITNESSED BY: IRON, S 89 E, 33.0'
NAIL S/S 40" OAK, N 20 W, 26.30'
NAIL TOP STUMP, N 53 E, 34.52'
6. CORNER REFERENCED IN SURVEY #3823, BY OSCAR BOSS, RLS #13574, DATED 06/04/ RECORDED IN LIBER 1, PAGE 835. "NW COR., SEC. 1, T1N, R1E, 1/2" IRON SET."
WITNESSED BY: S 89 E, 33.0 IRON
N 20 W, 26.30, NAIL S/S 40" OAK
N 53 E, 34.52, NAIL TOP STUMP

SURVEY SHOWS DISTANCE EAST TO L-1 OF 2629.55' (ACTUALLY L-13, INGHAM TWP.)
SURVEY SHOWS DISTANCE SOUTH TO K-2 OF 3036.35'

7. CORNER EXCAVATION REPORT (CETA PROJECT) DATED 11/21/1977, BY LARRY BRYAN, FIELD SUPERINTENDENT, STATES: "FD. 1/2" IRON," WITNESSED BY:
OAK 41" DIA. N 20 W 26.30' NAIL W/TAPE FROM OLD WITNESSES ON SW SIDE OF TREE WAS THERE AND USED
OAK 6" DIA. N 20 E 28.94' TAG & NAIL SET ON SE SIDE OF TREE
BLACK CHERRY 8" DIA. S 30 W 56.20' NAIL & TAG SET ON SE SIDE OF TREE
OAK 38" DIA. N 35 W 45.60' TAG & NAIL SET ON E. SIDE OF TREE.
FD. OLD WITNESS W/RLS#13574 ON OLD STUMP BUT WAS NOT USED BECAUSE STUMP WAS ROTTEN.

REPORT SHOWS THAT A 4' X 4' X 3.5' DEEP HOLE WAS EXCAVATED AROUND 1/2" IRON BAR
REPORT DOES NOT STATE IF ANYTHING WAS RECOVERED. REPORT FURTHER STATES THAT "RESET NEW 1/2" IRON BAR W/CAP. IN CENTER OF EXCAVATION SITE."
(LOCATION OF PREVIOUS 1/2" IRON BAR)

8. NO OTHER REFERENCES FOUND.

INGHAM COUNTY REGISTRY OF DEEDS
21005000
2000