

SURVEY & REMONUMENTATION COMMISSION
 APR 10 1995

LAND CORNER RECORDATION CERTIFICATE
 Filing Requirement of Act 74, Mich. P.A. 1970
 LESLIE

For corners INGHAM (County) Located In: _____ Corner Code # G-3

JUL 15 2 25 PM '94

REGISTER OF DEEDS
Paula J. Johnson
 INGHAM COUNTY, MICH.

- 1. Public Land Survey T 1N R 1W _____
 T _____ R _____
 T _____ R _____
 T _____ R _____
- 2. Property Controlling S _____ T _____ R _____
 in Section S _____ T _____ R _____
- 3. Miscellaneous S _____ T _____ R _____
 Property in Sec. S _____ T _____ R _____

Register of Deeds Stamp & File Number

- 4. Lot No. _____, Recorded Plat _____
- 5. Private Claims _____

	A	B	C	D	E	F	G	H	I	J	K	L
2	6		5		4		3		2		1	
3												
4	7		8		9		10		11		12	
5												
6	18		17		16		15		14		13	
7												
8	19		20		21		22		23		24	
9												
10	30		29		28		27		26		25	
11												
12	31		32		33		34		35		36	
13												

I, RON HELSEL, in a field survey on JUNE 16, 19 94, do hereby certify that under requirements of P.A. 74, Michigan P.A. of 1970, the corner points mentioned in lines 1 and 2 above were in conformance with regulations and rules therefore as required in the current manual of survey instructions of the United States Department of the Interior, Bureau of Land Management or by a decree of a Court of Law and/or that the corner points mentioned in lines 3, 4 and 5 above were in conformance with the rules of the Michigan Board of Land Surveyors or by a Decree of a Court of Law; established, re-established, monumented, re-monumented, recovered, found as expressed below:


NOTE: Not more than 4 corners, all in the same town and range, may be recorded on this certificate.

A. Description of original monument and accessories and/or subsequent restoration:
 ORIGINAL MONUMENT: POST SET BY HERVEY PARKE, U.S. DEPUTY SURVEYOR IN 1826.
 BEECH 6 S10-1/2E 13
 SUGAR 9 N45-1/2W 8-1/2

(CONTINUED ON BACK)

B. Description of corner evidence found and/or method applied in restoring or reestablishing corner:
 FOUND 1/2" REBAR WITH CAP #13574 ON FIELD LINES EAST, WEST AND SOUTH. MARKER SITS IN A CIRCLE OF STONES AND THE OLD WOOD ANCHOR POST WAS FOUND LYING ON THE GROUND 10'± EASTERLY. EXCAVATED THE AREA OF THE 1/2" BAR AND STONES BUT DID NOT FIND ANY FURTHER EVIDENCE OF THE CORNER. FOUND THE WILD CHERRY EAST AS WITNESSED BY L. BRYAN AND A QUAD 12" OAK (MEASURED AT BASE) SOUTH WHICH MAY HAVE BEEN CITED AS AN ELM BY HIM. DISTANCE MATCHED HIS TIE WITHIN .07'. MEASURED 790.6'± WEST TO THE PHYSICAL C/L OF EDEN ROAD, INDICATING THAT HENDRYX USED THIS CORNER IN HIS SURVEY IN 3-A ABOVE. ACCEPTED THE POSITION OF THE MARKER.

C. Description of monument for corner and accessories established to perpetuate locating the position of the corner:
 SET 3/4" X 24" FORM PIN WITH CAP LABELED P.A. 345.
 SET GALV. NAIL & TAG #18994 S/SIDE 14" W. CHERRY, EAST, 362.30'
 SET GALV. NAIL & TAG #18994 NW/SIDE 10" OAK, S18°W, 9.68'
 SET GALV. NAIL & TAG #18994 N/SIDE 4" ELM, S82°E, 13.06'
 SET GALV. NAIL & TAG #18994 S/SIDE 9" HICKORY, N87°W, 5.52'
 SET GALV. NAIL & TAG #18994 W/SIDE QUAD OAK, S03°W, 18.14'

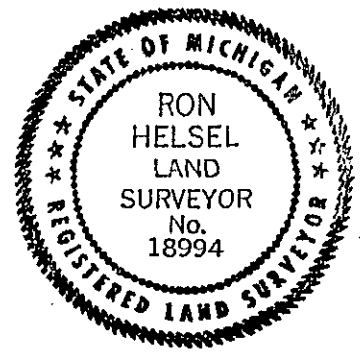

Signed by Ron Helsel Date JUNE 27, 1994
 Surveyor's Michigan License No. 18994

"A" CONTINUED

- 1). A SURVEY BY COUNTY SURVEYOR A. JACKSON IN 1852 USED THE SAME WITNESSES AS THE ORIGINAL GOVERNMENT SURVEY, VOL. 2, PAGE 133.
- 2). A SURVEY WAS RECORDED BY O. BOSS #13574 IN LIBER 1, PGS 1258 & 1259, FIELD DATED JAN., 1974. A C.R.C. WAS LATER RECORDED IN LIBER 3, PG 533 ON FEB. 3, 1976 AND FIELD DATED JAN., 1974 BY BOSS. BOTH DOCUMENTS CITED SETTING A 1/2" IRON BAR AT A FENCE INTERSECTION. WITNESSED AS:
DUE EAST, 2.43' NAIL S/SIDE 6" THORN TREE
DUE NORTH, 3.10' NAIL W/SIDE 4" THORN TREE
DUE WEST, 85.42' NAIL S/SIDE 18" TREE
- 3). A SURVEY WAS RECORDED IN LIBER 3, PG 453 BY L. HENDRYX #3276 AND DATED NOV. 4, 1977. NO DESCRIPTION OF THE MONUMENT OR WITNESSES WERE GIVEN. A REFERENCE TIE TO THE POINT OF BEGINNING OF HIS SURVEY WAS THE C/L OF EDEN ROAD, WEST, 791.6'.
- 4). A SURVEY WAS RECORDED IN LIBER 3, PGS 1102-1105 BY L. BRYAN #25832 AND DATED DEC., 1979. HE FOUND A "1/2" BAR & CAP AT CORNER POST R.L.S. #13574" (O. BOSS). WITNESSED AS:
SET NAIL & TAG WEST SIDE 4" ELM, SOUTH, 18.21'
SET NAIL & TAG SOUTH SIDE 12" WILD CHERRY, EAST, 362.25'

DID NOT FIND FURTHER MENTION OF THIS CORNER IN THE PUBLIC OR PRIVATE RECORDS.