

REMOVED

NOV 15 1994

LAND CORNER RECORDATION CERTIFICATE  
Filing Requirement of Act 74, Mich. P.A. 1970

LIBER 8 PAGE 150

For corners in COMMISSION  
INGHAM  
(County)

Located In: LESLIE  
Corner Code ##

FILED

- |                                    |   |           |   |           |            |
|------------------------------------|---|-----------|---|-----------|------------|
| 1. Public Land Survey              | T | <u>1N</u> | R | <u>1W</u> | <u>G-4</u> |
|                                    | T |           | R |           |            |
|                                    | T |           | R |           |            |
|                                    | T |           | R |           |            |
| 2. Property Controlling in Section | S |           | T | R         |            |
|                                    | S |           | T | R         |            |
| 3. Miscellaneous Property in Sec.  | S |           | T | R         |            |
|                                    | S |           | T | R         |            |
4. Lot No. \_\_\_\_\_, Recorded Plat \_\_\_\_\_
5. Private Claims \_\_\_\_\_

JUL 5 9 59 AM '94

REGISTER OF DEEDS  
*Paul J. Innes*  
INGHAM COUNTY, MICH.

Register of Deeds Stamp & File Number

I, RON HELSEL, in a field survey on OCT. 18, 19 93, do hereby certify that under requirements of P.A. 74, Michigan P.A. of 1970, the corner points mentioned in lines 1 and 2 above were in conformance with regulations and rules therefore as required in the current manual of survey instructions of the United States Department of the Interior, Bureau of Land Management or by a decree of a Court of Law and/or that the corner points mentioned in lines 3, 4 and 5 above were in conformance with the rules of the Michigan Board of Land Surveyors or by a Decree of a Court of Law; established, re-established, monumented, re-monumented, recovered, found as expressed below:

NOTE: Not more than 4 corners, all in the same town and range, may be recorded on this certificate.

A. Description of original monument and accessories and/or subsequent restoration:

ORIGINAL MONUMENT: POST SET BY HERVEY PARKE, U.S. DEPUTY SURVEYOR, FEB., 1826.  
WITNESSED AS: BEECH 12 N45-1/2 E 20  
W. ASH 9 S88W 16-1/2

(CONTINUED ON BACK)


B. Description of corner evidence found and/or method applied in restoring or reestablishing corner:

FOUND CONCRETE MONUMENT WITH CAP #18998 IN CONC. MON. BOX AT INTERSECTION OF THE C/L'S OF EDEN AND INGALLS ROADS. FOUND THE HICKORY, CHERRY AND POWER POLE AS DESCRIBED IN (7-A) ABOVE. DID NOT EXCAVATE AT SITE DUE TO THE EVIDENCE PROCURED BY LESTER IN JULY, 1978. REPLACED LESTER CAP WITH 1/2" PLASTIC CAP LABELED P.S. #18994 AS USED IN PRIVATE PRACTICE.

C. Description of monument for corner and accessories established to perpetuate locating the position of the corner:

MONUMENT WITH CAP #18994 IN CONC. COLLAR  
FOUND NAIL & TAG #18998, W/SIDE 20" HICKORY, S18°E, 127.45'  
FOUND NAIL & TAG #18998, E/SIDE POWER POLE, S41°W, 117.00'  
SET NAIL & TAG #18994, S/SIDE 14" CHERRY, N62°E, 41.50'  
SET NAIL & TAG #18994, S/SIDE 4" WOOD ANCHOR POST, S89°E, 34.00'

	A	B	C	D	E	F	G	H	I	J	K
2	6		5		4		3		2		
3											
4	7		8		9		10		11		
5											
6	18		17		16		15		14		
7											
8	19		20		21		22		23		
9											
10	30		29		28		27		26		
11											
12	31		32		33		34		35		
13											

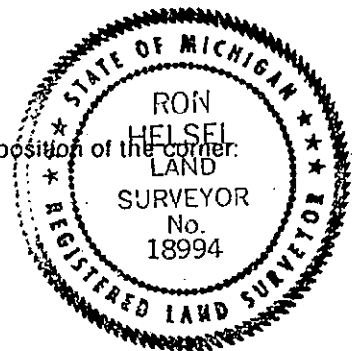

Signed by Ron Helsel Date JUNE 6, 1994

Surveyor's Michigan License No. 18994

2621

P.A. 345 INGHAM COUNTY  
PEER APPROVED 06/08/94 RL

## "A" CONTINUED

- 1). CORNER REFERENCED TO BY A. JACKSON, COUNTY SURVEY VOL. 2, P. 133 IN A SURVEY DATED DEC. 22, 1852. SAME BEARING TREES AS GOVERNMENT SURVEY.
- 2). CORNER REFERENCED TO BY A.P. DRAKE, COUNTY SURVEYOR VOL. 3, P. 128 IN A SURVEY DATED MAR. 24, 1877. STONE: CHERRY 15 S61-1/4E, 159  
HICKORY 6 S74W, 168
- 3). CORNER REFERENCED BY R.J. ROBB, COUNTY SURVEYOR AS A STONE WITH NO WITNESSES IN VOL. 2, P. 259, & VOL. 5, P. 50.
- 4). CORNER WAS IDENTIFIED AS A 1" GAS PIPE OR AN IRON STAKE BY W. BARRYMAN, COUNTY SURVEYOR, NO DATE GIVEN FROM FOLDER SET #1, PGS. 18 & 19.
- 5). THE CORNER WAS IDENTIFIED AS A 1" PIPE WITH BRICK IN THE INGHAM COUNTY ROAD COMMISSION RECORDS FROM 1969.
- 6). FROM THE RECORDS OF J.E. STEPHENS #16053, FIELD NOTE DATED 5/15/67, NOTED FOUND BOAT SPIKE.  
12" HICKORY, SSE, 127.88'  
8" CHERRY, NE, 42.15'  
P. POLE, NW, 29.27'  
TOP SOUTH END OF 12" C.M.P. UNDER INGALLS RD., WSW, 59.77'
- 7). A C.R.C. WAS RECORDED IN LIBER 5, P. 42 AND FIELD DATED JULY 3, 1978 BY R.M. LESTER #18998. LESTER NOTED THE FINDING OF A 1" BOLT ABOVE A WOOD STAKE DIRECTLY ABOVE A 1" PIPE SURROUNDED BY ROCKS, BRICKS & OVER A FLAT IRON BAR WITH A PLOW POINT & POTTERY. HE ACCEPTED THE FLAT IRON BAR & PLOW POINT AS THE CORNER MARKER. "SET 4" X 36" CONCRETE MONUMENT WITH 1/2" X 38" REROD WITH CAP #18998 & CONCRETE COLLAR AT LOCATION OF FLAT IRON BAR".  
NAIL & TAG #18998, S/SIDE 6" WILD CHERRY, ENE, 41.82'  
NAIL & TAG #18998, S/SIDE 5" ASH, EAST, 35.29'  
NAIL & TAG #18998, W/SIDE 16" HICKORY, SSE, 127.42'  
NAIL & TAG #18998, E/SIDE POWER POLE, SSW, 116.93'
- 8). A SURVEY WAS RECORDED IN LIBER 3, PGS. 1102-1105 BY L.A. BRYAN #25832, DATED 12-31-79. HE CITED THE MONUMENT SET BY LESTER, WITNESSED AS:  
FD. NAIL & TAG R.L.S. #18998, S/SIDE 12" W. CHERRY, N45°E, 41.82'  
FD. NAIL & TAG R.L.S. #18998, S/SIDE 6" HICKORY, N70°E, 35.33'  
FD. NAIL & TAG R.L.S. #18998, W/SIDE 18" HICKORY, S10°E, 127.48'