

NOV 15 1994

LAND CORNER RECORDATION CERTIFICATE

Filing Requirement of Act 74, Mich. P.A. 1970

LESLIE

FILED

For corners in COMMISSION INGHAM (County)

Located In: Corner Code #/

MAY 3 1 11 PM '94

REGISTER OF DEEDS Ingham County, Mich.

Register of Deeds Stamp & File Number

- 1. Public Land Survey T 1N R 1W I-1
2. Property Controlling in Section S T R
3. Miscellaneous Property in Sec. S T R

- 4. Lot No. Recorded Plat
5. Private Claims

Grid table with columns A-L and rows 1-13. Cell I-13 contains a dot.

I, RON HELSEL, in a field survey on OCT. 18 1993, do hereby certify that under requirements of P.A. 74, Michigan P.A. of 1970, the corner points mentioned in lines 1 and 2 above were in conformance with regulations and rules therefore as required in the current manual of survey instructions of the United States Department of the Interior, Bureau of Land Management or by a decree of a Court of Law and/or that the corner points mentioned in lines 3, 4 and 5 above were in conformance with the rules of the Michigan Board of Land Surveyors or by a Decree of a Court of Law; established, re-established, monumented, re-monumented, recovered, found as expressed below:

NOTE: Not more than 4 corners, all in the same town and range, may be recorded on this certificate.

A. Description of original monument and accessories and/or subsequent restoration:


THIS WAS A CLOSING CORNER SET BY HERVEY PARKE, U.S. DEPUTY SURVEYOR IN 1826. WITNESSED AS: B. ASH 6 IN., S56E, 25 D.O. 8 S83W, 28

1). NO OTHER PRIVATE OR PUBLIC SURVEYS WERE REFERENCED TO THIS CORNER EXCEPT AS DENOTED BELOW.

2). A C.R.C. WAS RECORDED IN LIBER 6, PG. 106 BY SURVEYOR R.M. LESTER, #18998 G.D. LESTER #17624 IN ACCORD WITH THE INGHAM CO. REMONUMENTATION PROGRAM OF THE LATE 1970'S IN WHICH THE FOLLOWING WAS RECORDED. (CONTINUED ON BACK)

B. Description of corner evidence found and/or method applied in restoring or reestablishing corner:

FOUND CONCRETE MON WITH CAP #18998 IN MONUMENT BOX 1'+ SOUTH OF C/L OF PLAINS HWY. ON TREE LINE TO SOUTH. FOUND: 44" MAPLE & TAG #18998, SOUTH, 28" ASH TO SW CORNER I-13 (VEVAY TWP.) EAST SINCE EXCAVATION IN 1980 WAS 10' X 10', DID NOT SEARCH FURTHER, AND ACCEPTED THIS CORNER BY THE EVIDENCE DETERMINED BY POLARIS IN 1980 WITH ENOUGH WITNESSES TO PROVE ITS LOCATION.

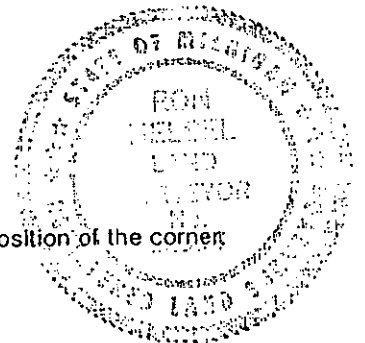

C. Description of monument for corner and accessories established to perpetuate locating the position of the corner:

1/2" IRON BAR ENCASED IN CONCRETE IN MON. BOX FOUND NAIL & TAG #18998 E/SIDE 44" MAPLE, S04°W, 25.83' SET GALV. NAIL & TAG #18994 N/SIDE 28" ASH, S72°W, 61.43' SET GALV. NAIL & TAG #18994 E/SIDE 22" ASH, S37°W, 29.13' SET GALV. NAIL & TAG #18994 W/SIDE 10" MAPLE CLUMP, N06°E, 32.57' FOUND 1/2" BAR ENCASED IN CONCRETE IN MON. BOX (I-13 VEVAY TWP.) EAST, 106.33'

Signed by Ron Helsel Date APRIL 11, 1994 Surveyor's Michigan License No. 18994

"A" CONTINUED

"EXCAVATED A 10' X 10' HOLE TO AN AVERAGE DEPTH OF 3.6' ON CENTERLINE OF PLAINS ROAD AND FENCE LINE SOUTH, +106' WEST OF CENTERLINE OF IVES ROAD TO THE NORTH. NO EVIDENCE FOUND. CORNER CONSIDERED LOST. CORNER SET ON THE STANDARD TOWNSHIP LINE AT THE GLO FALLING (106.26') WEST OF I-13 VEVAY TWP. +1.0' SOUTH OF THE CENTERLINE OF PLAINS ROAD ON THE TREE LINE SOUTH."

WITNESSED:

"SET 4" X 36" CONCRETE MONUMENT WITH 1/2" X 38" REROD & CAP #18998 WITH CONCRETE COLLAR AND COVER."

NAIL & TAG #18998 WEST SIDE POWER POLE, NE, 49.82'

NAIL & TAG #18998 NORTHWEST SIDE 28" ASH, SW, 62.02'

NAIL & TAG #18998 EAST SIDE 20" HICKORY, SSW, 28.99'

NAIL & TAG #18998 EAST SIDE 42" MAPLE, SOUTH, 25.95'

1/2" IRON WITH CAP #18998, I-13 VEVAY TWP., T2N,R1W, EAST, 106.26'

- 3). AN UNRECORDED SURVEY #90-B-29183 BY L. BRYAN #25832, AND DATED 5-22-90
 WITNESSED AS: CONC. MON 2'+ SOUTH OF C/L PLAINS HWY. AND ON THE FENCE LINE
 TO THE SOUTH. WITNESSED AS: FOUND 1/2" IRON BAR C/L PLAINS & IVES RD. TO NORTH
 (SW COR., SEC. 5, T2N,R1W) EAST, 106.20'
 FD. NAIL & TAG #18998 E/SIDE 36" MAPLE, SOUTH,
 25.85'
 SET "P.K." NAIL E/SIDE 30" ASH, S30°W, 28.99'
 SET "P.K." NAIL NW/SIDE 30" ASH, S60°W, 62.02'
 SET "P.K." NAIL W/SIDE 8" MULTI-MAPLE, NORTH,
 32.57'

- 4). A P.A. 132 SURVEY WAS RECORDED IN L.6, PG. 881 BY R. HELSEL #18994, DATED
 3-20-94, THE WITNESSES DESCRIBED AS: "FD. 4" X 36" CONCRETE MON WITH
 1/2" X 38" REROD & CAP #18998 WITH
 CONC. COLLAR
 NAIL & TAG #18998, NW/SIDE 28" ASH,
 SW, 62.02'
 NAIL & TAG #18998, E/SIDE 20" ASH,
 SSW, 28.99'
 NAIL & TAG #18998, E/SIDE 42" MAPLE
 SOUTH, 25.95'
 1/2" IRON WITH CAP #18998, I-13, VEVAY
 TWP., T2N,R1W, EAST, 106.26'