

**SURVEY & REMONUMENTATION**  
**APR 10 1995**  
**COMMISSION**

**LAND CORNER RECORDATION CERTIFICATE**

Filing Requirement of Act 74, Mich. P.A. 1970

LIBER 8 PAGE 195

For corners in  
INGHAM  
(County)

Located In:

LESLIE

Corner Code #

FILED

- |                                    |   |           |   |           |            |
|------------------------------------|---|-----------|---|-----------|------------|
| 1. Public Land Survey              | T | <u>1N</u> | R | <u>1W</u> | <u>I-3</u> |
|                                    | T |           | R |           |            |
|                                    | T |           | R |           |            |
|                                    | T |           | R |           |            |
| 2. Property Controlling in Section | S |           | T | R         |            |
|                                    | S |           | T | R         |            |
| 3. Miscellaneous Property in Sec.  | S |           | T | R         |            |
|                                    | S |           | T | R         |            |

JUL 15 2 24 PM '94

REGISTER OF DEEDS  
*Paul Johnson*  
 INGHAM COUNTY, MICH.  
 Register of Deeds Stamp & File Number

4. Lot No. \_\_\_\_\_, Recorded Plat \_\_\_\_\_  
 5. Private Claims \_\_\_\_\_

A	B	C	D	E	F	G	H	I	J	K	L
2	6	5	4	3	2	1					
3											
4	7	8	9	10	11	12					
5											
6	16	17	16	15	14	13					
7											
8	19	20	21	22	23	24					
9											
10	30	29	28	27	26	25					
11											
12	31	32	33	34	35	36					
13											

I, RON HELSEL, in a field survey on OCT. 19, 19 93, do hereby certify that under requirements of P.A. 74, Michigan P.A. of 1970, the corner points mentioned in lines 1 and 2 above were in conformance with regulations and rules therefore as required in the current manual of survey instructions of the United States Department of the Interior, Bureau of Land Management or by a decree of a Court of Law and/or that the corner points mentioned in lines 3, 4 and 5 above were in conformance with the rules of the Michigan Board of Land Surveyors or by a Decree of a Court of Law; established, re-established, monumented, re-monumented, recovered, found as expressed below:

**NOTE: Not more than 4 corners, all in the same town and range, may be recorded on this certificate.**

A. Description of original monument and accessories and/or subsequent restoration:

ORIGINAL MONUMENT: POST SET BY HERVEY PARKE, U.S. DEPUTY SURVEYOR, FEB. 20, 1826.  
 WITNESSED AS: W. OAK 36 N25°W 4-1/2  
 BEECH 18 S23-1/2E 42

1). OF THE COUNTY SURVEYS OF RECORD, NONE WERE REFERENCED TO THIS CORNER.


(CONTINUED ON BACK)

B. Description of corner evidence found and/or method applied in restoring or reestablishing corner:

FOUND THE BAR & CAP #25832 FROM THE BEARING TREES OF BRYAN'S C.R.C. NAILS WERE RUSTED AWAY. THE AREA LACKED ANY FENCES OR TREE ROWS DEFINING A TITLE LINE. BECAUSE OF THE EXTENSIVE EXCAVATION BY BYRAN, ACCEPTED THE POSITION OF HIS MARKER FOR THIS CORNER. SET NEW NAILS & TAGS.

C. Description of monument for corner and accessories established to perpetuate locating the position of the corner:

1/2" IRON BAR & CAP #25832  
 SET GALV. NAIL & TAG #18994 S/SIDE 12" W. CHERRY, N84°E, 21.14'  
 SET GALV. NAIL & TAG #18994 SE/SIDE 10" OAK, N27°E, 20.80'  
 SET GALV. NAIL & TAG #18994 N/SIDE TWIN 18" MAPLE, N69°W, 17.06'  
 SET GALV. NAIL & TAG #18994 NE/SIDE TWIN 10" OAK, S58°E, 13.03'  
 SET GALV. NAIL & TAG #18994 W/SIDE 12" OAK, NORTH, 28.06'  
 MEAS. 2652.07' TO I-2  
 MEAS. 2664.41' TO J-3

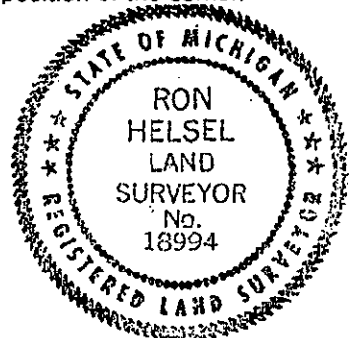

Signed by Ron Helsel Date JULY 13, 1994

Surveyor's Michigan License No. 18994

P.A. 345 INGHAM COUNTY  
 PEER APPROVED 7/13/94 M

"A" CONTINUED

- 2). A C.R.C. WAS RECORDED IN LIBER 5, PG. 382 & FIELD DATED DEC. 31, 1979 BY L. BRYAN #25832 "EXCAVATED HOLE 22' X 10' TO A DEPTH 1.0 FEET (0.5 BELOW TOP SOIL) CENTERED AROUND LOCATION ESTABLISHED BY DOUBLE PROPORTIONATE MEASUREMENT. EXCAVATION REVEALED NO EVIDENCE OF CORNER. ACCEPTED LOCATION ESTABLISHED BY DOUBLE PROPORTIONATE MEASUREMENT AS CORNER LOCATION."  
SET 1/2" BAR & CAP  
SET NAIL & TAG SOUTH SIDE 8" WILD CHERRY, EAST, 21.00'  
SET NAIL & TAG NORTH SIDE 24" MAPLE, N70°W, 17.11'  
SET NAIL & TAG SE SIDE 8" OAK, N30°E, 20.68'
- 3). A SURVEY WAS RECORDED IN LIBER 6, PGS. 881 & 882, & DATED MARCH 20, 1991 BY R. HELSEL #18994. BRYAN'S WITNESSES WERE FOUND INTACT AND AN ADDITIONAL WITNESS OF 12" OAK NORTH 28.0'
- DID NOT FIND FURTHER MENTION OF THIS CORNER IN PUBLIC OR PRIVATE RECORDS.