

NOV 5 1993

COMMISSION

Leslie Township

LAND CORNER RECORDATION CERTIFICATE
Filing Requirement of Act 74, Mich. P.A. 1970

NOV 10 11 38 AM '93


REGISTER OF DEEDS
Paula Johnson
INGHAM COUNTY, MICH.

For corners in

Ingham
(County)

Located In: Corner Code #

- | | | | | |
|---------------------------------------|---|-------|----|-------|
| | | 1N | 1W | J-7 |
| 1. Public Land Survey | T | _____ | R | _____ |
| | T | _____ | R | _____ |
| | T | _____ | R | _____ |
| | T | _____ | R | _____ |
| 2. Property Controlling in Section | S | _____ | T | _____ |
| | S | _____ | T | _____ |
| 3. Miscellaneous Property in Sec. | S | _____ | T | _____ |
| | S | _____ | T | _____ |
| 4. Lot No. _____, Recorded Plat _____ | | | | |
| 5. Private Claims _____ | | | | |

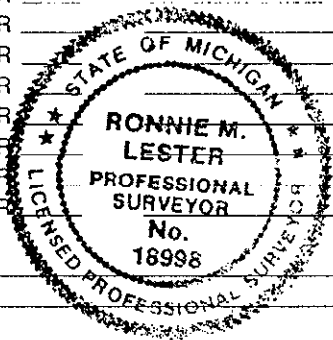

Register of Deeds Stamp & File Number

A	B	C	D	E	F	G	H	I	J	K	L	M
2	6	5	4	3	2	1						
3												
4	7	8	9	10	11	12						
5												
6	18	17	16	15	14	13						
7												
8	19	20	21	22	23	24						
9												
10	30	29	28	27	26	25						
11												
12	31	32	33	34	35	36						
13												

Ronnie M. Lester October 29 19 93
 I, _____, in a field survey on _____, 19 _____, do hereby certify that under requirements of P.A. 74, Michigan P.A. of 1970, the corner points mentioned in lines 1 and 2 above were in conformance with regulations and rules therefore as required in the current manual of survey instructions of the United States Department of the Interior, Bureau of Land Management or by a decree of a Court of Law and/or that the corner points mentioned in lines 3, 4 and 5 above were in conformance with the rules of the Michigan Board of Land Surveyors or by a Decree of a Court of Law; established, re-established, monumented, re-monumented, recovered, found as expressed below:

NOTE: Not more than 4 corners, all in the same town and range, may be recorded on this certificate.

A. Description of original monument and accessories and/or subsequent restoration:

GLO record indicates: "39.98 set 1/4 post on true line W oak, 36, N84°E 35 1/2; Beech, 12, S86°W, 21". Surveyed by Harvey Parke, February 1826.
 (1) Ingham County Road Commission Record indicates: "stone, plowpoint, crockery, NE corner school wall, SSW 183.0' and SE Corner wall Northwest, 102.2'". No date or reference given.
 (2) I recorded this corner in Liber 3, Page 171 of PA 74, 1970 record on July 12, 1974. Used the accessories given by Ingham County Road Commission record to set 1/2" bar in centerline of road intersection. Left witnesses of:
SEE BACK OF DOCUMENT

B. Description of corner evidence found and/or method applied in restoring or reestablishing corner:

Investigation at this corner revealed a 1/2" bar in a monument box located in the centerline of Wright Road and the centerline of Kinneville Road. Monument box was filled with water. Did not excavate through monument box because of water. Both building corners as referenced by the Ingham County Road Commission are still standing in good condition. Distances to building corners are as found in 1974. I believe this is the perpetuated location of the South 1/4 Corner of Section 14, Leslie Township.

C. Description of monument for corner and accessories established to perpetuate locating the position of the corner:

Placed identification cap on 1/2" bar located in monument box in centerline of intersection of Wright Road and Kinneville Road.
 Southeast corner of house foundation, 322° az., 102.20'
 Northeast corner foundation of brick school dated "1883" 211° az., 183.03'
 Set galvanized nail and 1 1/4" brass tag stamped "LS 18998" in East side 24" oak, 335° az., 65.76'
 Set galvanized nail and 1 1/4" brass tag stamped "LS 18998" in North side 24" maple, 245° az., 84.61'

Signed by *Ronnie M. Lester* Date November 4, 1993
 Surveyor's Michigan License No. 18998

2546

CONTINUED FROM FRONT OF DOCUMENT - Part "A"

SE Corner of wall, NW 102.2'

Nail and tag East side 36" maple, NW 66.04'

Nail and tag North side 20" maple, SW 117.60'

Nail and tag North side 20" maple, SW 85.06'

(3) I used this corner in a survey as recorded in Liber 2, Page 9 and 10 of surveys recorded per PA 132 of 1970 dated May 6, 1974. Witnesses same as in item (2).

(4) This corner was utilized by George M. Young, PS #17640 in a survey recorded in Liber 3, Pages 1049-1051 per PA 132, 1970 dated 6/13/1979. He references Liber 3, Page 171 of PA 74 records and utilizes same witnesses as (2).

(5) This corner was utilized by Ron Helsel, PS #18994 in a survey recorded in Liber 6, Page 528 per PA 132 of 1970 dated 2/20/1990. Indicates "found 1/2" bar in monument box" and references Liber 3, Page 171 of PA 74 records. No witnesses given.

No other record found on public record.