

DEC 14 1993

COMMISSION

P12-46-14-K7

LIBER 8 PAGE 75

Leslie Township

LAND CORNER RECORDATION CERTIFICATE

Filing Requirement of Act 74, Mich. P.A. 1970

FILED

of corners in


Ingham

(County)

Located In:

Corner Code ##

Public Land Survey	T	1N	R	1W	K-7
	T		R		
	T		R		
	T		R		
Property Controlling in Section	S		T		R
Miscellaneous Property in Sec.	S		T		R
	S		T		R
Lot No. _____, Recorded Plat _____					
Private Claims _____					

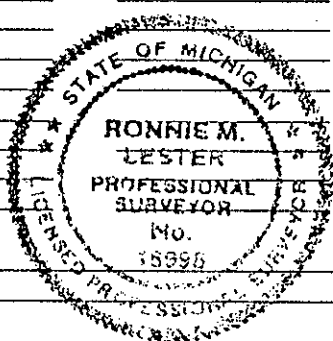

Dec 2 10 08 AM '93

REGISTER OF DEEDS

Paula Johnson
INGHAM COUNTY, MICH.

Register of Deeds Stamp & File Number

	A	B	C	D	E	F	G	H	I	J	K	L	M
2	6	5	4	3	2	1							
3													
4	7	8	9	10	11	12							
5													
6	13	17	16	15	14	13							
7													
8	19	20	21	22	23	24							
9													
10	30	29	28	27	26	25							
11													
12	31	32	33	34	35	36							
13													

Ronnie M. Lester, in a field survey on October 29, 1993

to hereby certify that under requirements of P.A. 74, Michigan P.A. of 1970, the corner points mentioned in lines 1 and 2 above were in conformance with regulations and rules therefore as required in the current manual of survey instructions of the United States Department of the Interior, Bureau of Land Management or by a decree of a Court of Law and/or that the corner points mentioned in lines 3, 4 and 5 above were in conformance with the rules of the Michigan Board of Land Surveyors or by a Decree of a Court of Law; established, re-established, monumented, re-monumented, recovered, found as expressed below:

NOTE: Not more than 4 corners, all in the same town and range, may be recorded on this certificate.

1. Description of original monument and accessories and/or subsequent restoration:

GLO record indicates: "Set post to cor. sec. 13, 14, 23, 24. W. oak 24, N66°W, 40 and Boxwood 5, S87 1/2°E 15 ". Surveyed by Harvey Parke, February 1826. (1) Glen Fauser, PS #18657 recorded corner per Act 74, PA 1970 on document recorded in Liber 5, Page 56 of LCRC dated 10/27/1978. He indicates "Found railroad spike" with witnesses: 22" maple N02°W 30.24' to nail; 24" maple S30°W 53.21' to nail; Steel fence corner post, South, 26.00. "Corner is in Centerline of East-West Road"

SEE BACK OF DOCUMENT

3. Description of corner evidence found and/or method applied in restoring or reestablishing corner:

Investigation at this corner revealed a railroad spike in a monument box located in the centerline of Kinneville Road and on occupation line North and South. Excavated monument box to depth of 3.0 feet. Found nail 1.0' deep. Found nothing else but small stones in sand sub-base. Accepted the location of the railroad spike as the perpetuated location of the Southeast Corner of Section 14, Leslie Township as recorded in Liber 5, Page 56 of LCRC. Set 1/2" x 18" smooth bar with yellow cap stamped "LS #18998" in monument box at location of railroad spike. Physical location of railroad spike matches Liber 5, Page 56 and two of the maple tree witnesses are standing.

C. Description of monument for corner and accessories established to perpetuate locating the position of the corner:

K-7, T1N, R1W.
1/2" bar and identification cap in monument box as described above.
Set galvanized nail and 1 1/4" brass tag stamped "LS 18998" in East side 28" maple, 05° az., 31.06'.
Set galvanized nail and 1 1/4" brass tag stamped "LS 18998" in Northwest side 36" maple, 218° az., 53.22'.
Northeast corner of brick chimney 213° az., 100.10'
Set galvanized nail and 1 1/4" brass tag stamped "LS 18998" South side 15" maple, 82° az., 141.18'

Signed by

Ronnie M. Lester

Date

November 29, 1993

Surveyor's Michigan License No.

18998

CONTINUED FROM FRONT OF DOCUMENT - Part "A"

(2) Glen Fauser, PS #18657 utilized this corner in Survey recorded per Act 132, PA 1970 recorded in Liber 1, Page 754 and dated May 29, 1973. Witnesses for corner are same as indicated in (1)

(3) Glen Fauser, PS #18657 utilized this corner in Survey recorded per Act 132, PA 1970 recorded in Liber 3, Page 824 and dated December 1978. No witnesses for corner or description of monument given.

(4) Glen Fauser, PS #18657 utilized this corner in Survey recorded per Act 132, PA 1970 recorded in Liber 3, Page 825 and dated January 1979. No witnesses for corner or description of monument given.

(5) George Young, PS #17640 utilized this corner in Survey recorded per Act 132, PA 1970 recorded in Liber 3, Page 1049 and dated 6/13/79. indicates "Fd. RR spike" and uses witnesses identical to those in LCRC document recorded in Liber 5, Page 56. (1)

(6) George Young, PS #17640 utilized this corner in Survey recorded per Act 132, PA 1970 recorded in Liber 3, Page 1130 and dated 11/30/79. indicates "Fd. RR spike" and uses witnesses identical to those in LCRC document recorded in Liber 5, Page 56. (1)

(7) Ronald L. Enger, PS #28409 utilized this corner in Survey recorded per Act 132, PA 1970 recorded in Liber 6, Page 901 and dated 12/26/91. "Refer to CRC in Liber 5, Page 56. Found railroad spike in monument box".

No other information found on public record.