DEC 1 2 1997

COMMISSIC	jN LAND	CORNER RECORDATION				
For corners in LESLIE TOWNS		g Requirement of Act 74, I	/// // // // // // // // // // // // //	Liber	9 Page	277
INGHAM COUNTY	Located In:	Corner Code #		r	ILED	
1. Public Land Survey	T <u>1N</u> R <u>1</u> ' T R_ T R_			12/02/ REGIS Pau	70047746 1997 13:38:18 TER OF DEEDS la Johnson AN COUNTY,MI	
Property Controlling Sin Section S Miscellaneous S Property in Sec. S	R				eeds Stamp 8	& File Number
4. Lot No, Records	ed Plat		_			
5. Private Claims			_ 1 1	BCD	е	JKL
I, Maurice H. Mahieu, in a fierequirements of P.A. 74, Michigan were in conformance with regulationstructions of the United States decree of a Court of Law and for conformance with the rules of the Law; established, re-established, re-est	n P.A. of 1970, the contions and rules therefore Department of the lithat the corner points the Michigan Board of	orner points mentioned in lines 1 ore as required in the current man interior, Bureau of Land Manager is mentioned in lines 3, 4 and 5 a Land Surveyors or by a Decree of	and 2 above 3 ual of survey 4 nent or by a bove were in 5	7 8 17	9 10	11 12
NOTE: Not more than 2 corners on this certificate.	s, all in the same tow	n and range, may be recorded	8	19 20	21 22	23 24
			9 10	30 29	28 27	26 25
A. Description of original mo	nument and access	sories and/or subsequent resto	oration:			
1. Corner was not set in			12	31 32	33 34	35 36
2. County Surveyor A. Ja 1841. Cited W. Oak 1			Nov. 20, 13			
3. Ronnie Lester, P.S. #1	8998, determined of quarter lines in	d corner was lost and set in May 1981, from 1978 In	/2" iron gham			
 Larry Bryan, P.S. #258 finding 1/2" iron rod at Williams), South 43.30 	332, recorded a L. nd cap as called f D'; Nail and Tag #	.C.R.C. in Liber 6, Page 37 for by County witnesses. 18998 West Side Fence P nd Tag #18998 East Side I	Witnesses: 1/3 ost, North 21.9	2" Bar and C 4'; Nail and	Cap #21275	(Austin 8 Northeast
5. Larry Bryan, P.S. #258 recorded finding 1/2"	332, recorded a P bar 10.5' North o	.A. 132 survey in Liber 6, of centerline of Vaughn Roes the same witnesses as A	Pages 196-197, ad on fence line	on June 18 North, from 2675.96 to	ı Ingham Co	unty
B. Description of corner evid	dence found and/or	method applied in restoring of	r reestablishing co		(00)(11)(00)	on Buon,
Found 1/2" Iron at North e As stated in Larry Bryan's position is correct. Replace	L.C.R.C. recorded	l in Liber 6, Page 371, I fe	el Ron Lesters n	nethod of es	tablishing th	ie corner
C. Description of monument for	or corner and acces	ssories established to perpetu	ate locating the po	sition of the	corner:	
Set standard 3/4" iron rod Set Nail and Tag #28414 S Set Nail and Tag #28414 S Set Nail and Tag #28414 V Set Nail and Tag #28414 B	East Side Wood Fo South Side 10" Po West Side Wood I East Side 18" Pop	ence Post, North 22.02' oplar, N 45° E 80.17' Mail Box Post, S 5° W 24. dar, N 50° W 34.25'		iron rod. W	/itnesses:	
Signed by Mau	rin All	Mahie	Date	25-97		
Surveyor's Michigan Licens		•				

MAURICE H.

* MAHIEU

PROFESSIONAL SURVEYOR


No.

28414

PROFESSIONAL SURVEYOR

NO.

28414

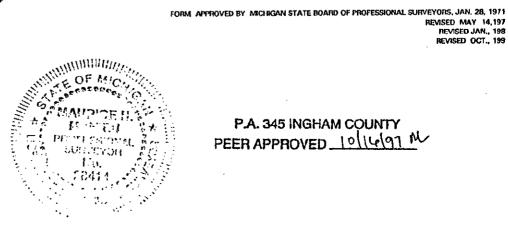

P.A. 345 INGHAM COUNTY PEER APPROVED 10/14/91 M

State In

(A-Continued)

6. Larry Bryan, P.S. #25832, recorded a P.A. 132 survey in Liber 7, Pages 371-372, on Nov. 2, 1994. He recorded finding 1/2" bar at North edge of asphalt on Vaughn Road, he states the same witnesses as A-4. Measured 2,675.96 to M-2.

7. Unrecorded survey by Larry Bryan P.S. #25832 on June 6, 1995 notes corner as found axle shaft in rock pile on Tree line Southwitnessed by:

Found Nail and Tag Northwest side Twin 10" Cherry N45° E 25.25' Set Nail and Tag South side 24" Maple East 33.10' Set Nail and Tag West side 12" Cherry S 35° W 30.40' Set Nail and Tag West side 10" Cherry South 42.89' Measured 2676.12 to M-2 and 2663.05 to L-3.