

NOV 15 1994

LAND CORNER RECORDATION CERTIFICATE
Filing Requirement of Act 74, Mich. P.A. 1970

LIBER 8 PAGE 154
FILED

For corners in COMMISSION
INGHAM
(County)

Located In: LESLIE TWP.
Corner Code: ##

- 1. Public Land Survey T 1N R 1W M-11
T _____ R _____
T _____ R _____
T _____ R _____
- 2. Property Controlling S _____ T _____ R _____
in Section S _____ T _____ R _____
- 3. Miscellaneous S _____ T _____ R _____
Property in Sec. S _____ T _____ R _____

JUL 5 10 00 AM '94

REGISTER OF DEEDS
Paula Johnson
INGHAM COUNTY, MICH.

Register of Deeds Stamp & File Number

- 4. Lot No. _____, Recorded Plat _____
- 5. Private Claims _____

	A	B	C	D	E	F	G	H	I	J	K	L
2	6	5	4	3	2	1						
3												
4	7	8	9	10	11	12						
5												
6	18	17	16	15	14	13						
7												
8	19	20	21	22	23	24						
9												
10	30	29	28	27	26	25						
11												
12	31	32	33	34	35	36						
13												

I, RON HELSEL, in a field survey on MARCH 10, 19 94, do hereby certify that under requirements of P.A. 74, Michigan P.A. of 1970, the corner points mentioned in lines 1 and 2 above were in conformance with regulations and rules therefore as required in the current manual of survey instructions of the United States Department of the Interior, Bureau of Land Management or by a decree of a Court of Law and/or that the corner points mentioned in lines 3, 4 and 5 above were in conformance with the rules of the Michigan Board of Land Surveyors or by a Decree of a Court of Law; established, re-established, monumented, re-monumented, recovered, found as expressed below:

NOTE: Not more than 4 corners, all in the same town and range, may be recorded on this certificate.


A. Description of original monument and accessories and/or subsequent restoration:
ORIGINAL MONUMENT: POST SET BY U.S. DEPUTY SURVEYOR. WITNESSED AS:
W.O. 38 S75°W, 138 LKS
W.O. 36 N29°W, 154 LKS
DID NOT FIND ANY PUBLIC OR PRIVATE SURVEYS REFERENCED TO THIS CORNER.

(CONTINUED ON BACK)

B. Description of corner evidence found and/or method applied in restoring or reestablishing corner:
AREA OF THE STONE HAD BEEN BACK FILLED WITH CLAY BY CONSTRUCTION OF A PRIVATE OPEN DRAIN. RESIDENT KEITH KNOBLAUCH VISITED THE SITE AND REMEMBERED THE STONE AND ITS APPROXIMATE LOCATION. IT WAS HIS OPINION THAT THE STONE WAS AN EXCEPTED MARKER BY THE ABUTTING NEIGHBORS.

(CONTINUED ON BACK)

C. Description of monument for corner and accessories established to perpetuate locating the position of the corner:
3/4" FORM PIN OVER BLUE STONE
SET GALV. NAIL & TAG #18994 NE/SIDE 10" PINE, N30°W, 163.98'
SET GALV. NAIL & TAG #18994 S/SIDE 30" OAK, S75°W, 206.50'
SET GALV. NAIL & TAG #18994 N/SIDE 14" MAPLE, S40°W, 275.10'
SET P.K. NAIL IN C/L OLDS ROAD, SOUTH, 23.46'

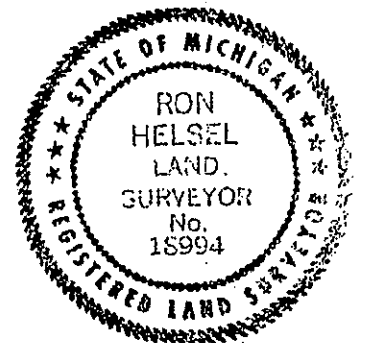

Signed by Ron Helsel Date MARCH 11, 1994
Surveyor's Michigan License No. 18994

2623

P.A. 345 INGHAM COUNTY
PFFR APPROVED 04/13/94 ML

"A" CONTINUED

THE INGHAM CO. REMON. CREW FOUND A BLUE STONE ON 11-8-1978 AND WITNESSED AS:

FD. BLUE STONE AT GROUND SURFACE

SET N/TAG #18998 NW/SIDE 8" ASH, S60°W, 113.27'

SET N/TAG #18998 W/SIDE 8" ASH, S05°E, 76.62'

SET N/TAG #18998 N/SIDE 8" ASH, N85°W, 139.06'

POSITION OF STONE WAS 22' NORTH OF THE PHYSICAL C/L OF OLDS RD ON A FENCE LINE TO THE SOUTH AND AN OCCUPATION TREE ROW 1000± NORTH.

"B" CONTINUED

EXCAVATED A HOLE 3' WIDE X 6' LONG X 3' DEEP IN THE VICINITY POINTED OUT BY MR. KNOBLAUCH. FOUND A POINTED AND CHISELED BLUE STONE ABOVE REMNANTS OF A ROTTED POST IN A HORIZONTAL POSITION. MEASURED 76.5'± TO THE ROTTED STUMP OF A TREE TO THE SOUTH WHICH MAY HAVE BEEN THE ASH WITNESSED BY THE REMON. CREW.

MEASURED 2640.95' TO M-12 (G.L.O. 2640).

MEASURED 2643.57' TO M-10 (G.L.O. 2640).

ACCEPTED THE STONE AS THE CORNER MARKER AND RAISED TO GRADE WITH A 3/4" X 24" FORM PIN AND CAP #18994.