INGHAM

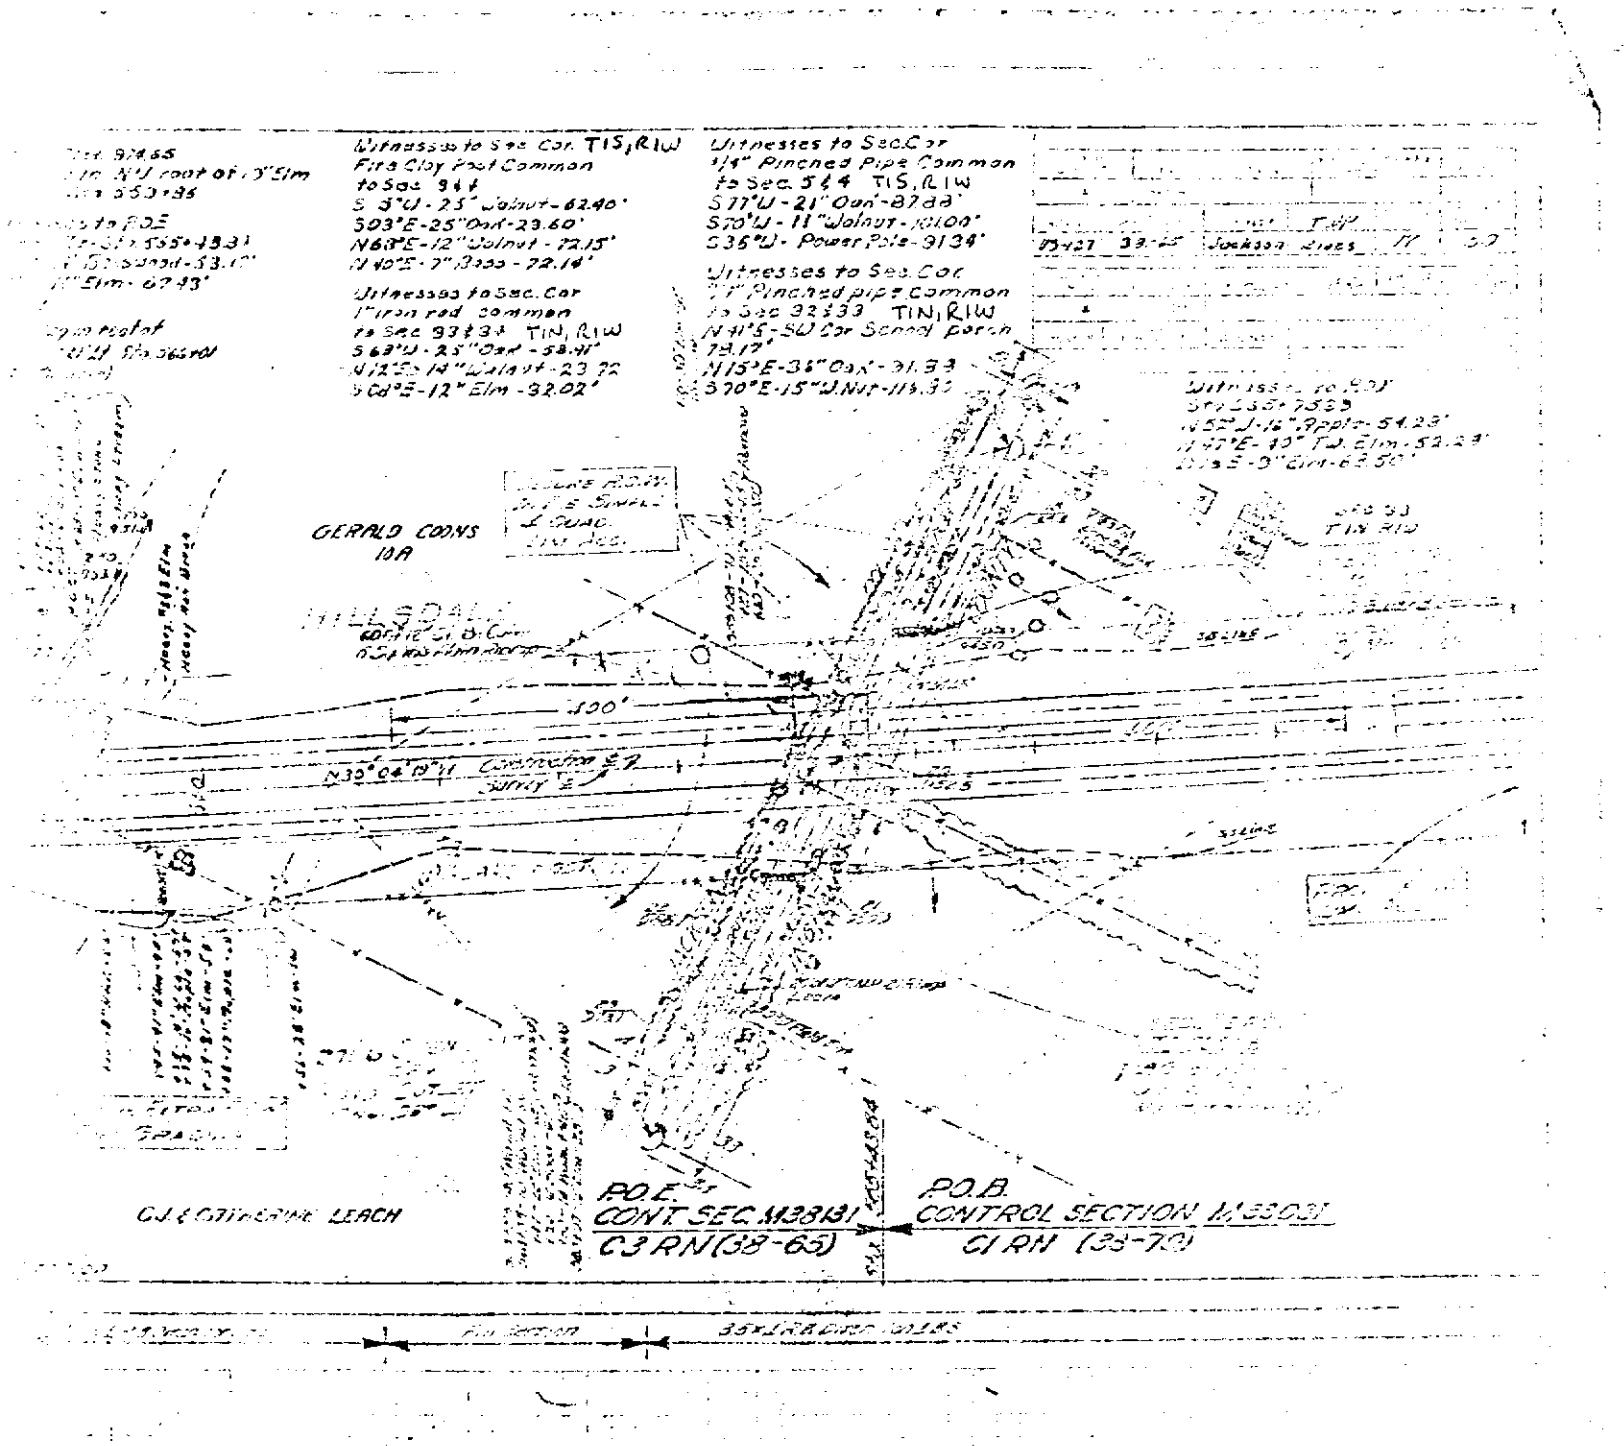

Witnesses to Sec. Cor. T1S, R1W
Fire Clay Post Common
to Sec. 3 & 4
S 5°W - 25" Walnut - 62.40'
S03°E - 25" Oak - 23.60'
N68°E - 12" Walnut - 72.15'
N 40°E - 7" Bass - 72.14'
Witnesses to Sec. Cor
1" Iron rod common
to Sec. 33 & 34 T1N, R1W
S 63°W - 25" Oak - 58.41'
N 12°E - 14" Walnut - 23.72
S 60°E - 12" Elm - 32.02'
Witnesses to Sec. Cor
3/4" Pinched Pipe Common
to Sec. 5 & 4 T1S, R1W
S 77°W - 21" Oak - 87.88'
S70°W - 11" Walnut - 101.00'
S 35°W - Power Pole - 91.34'
Witnesses to Sec. Cor
1" Pinched pipe common
to Sec. 32 & 33 T1N, R1W
N 41°E - SW Cor School porch
78.17'
N 15°E - 36" Oak - 91.33
S 70°E - 15" W. Nut - 115.33
Jackson Lines
GERALD COONS
10A
HILLSDALE
400'
N30°04'19"W
Construction ℄
Survey ℄
C.J. & CATHERINE LEACH
P.O.E.
CONT. SEC. M38131
C3 RN (38-65)
P.O.B.
CONTROL SECTION M33031
C1 RN (33-70)