

DEC 12 1997

COMMISSION

LAND CORNER RECORDATION CERTIFICATE
Filing Requirement of Act 74, Mich. P.A. 1970

Liber 9 Page 264

For corners in

<u>INGHAM</u> (County)	Located In:	Corner Code #
STOCKBRIDGE TOWNSHIP	T 1N R 2E	A-2
1. Public Land Survey	T _____ R _____	_____
	T _____ R _____	_____
	T _____ R _____	_____
2. Property Controlling in Section	S _____ T _____ R _____	_____
	S _____ T _____ R _____	_____
3. Miscellaneous Property in Sec.	S _____ T _____ R _____	_____
	S _____ T _____ R _____	_____
4. Lot No. _____, Recorded Plat _____		
5. Private Claims _____		

FILED

970044056
11/05/1997 12:39:46
REGISTER OF DEEDS
Paula Johnson
INGHAM COUNTY, MI

Register of Deeds Stamp & File Number

I, DAVID L. CLIFFORD, in a field survey on SEPT. 23, 1997 do hereby state that under requirements of P.A. 74, Michigan P.A. of 1970, the corner points mentioned in lines 1 and 2 above were in conformance with regulations and rules therefore as required in the current manual of survey instructions of the United States Department of the Interior, Bureau of Land Management or by a decree of a Court of Law and for that the corner points mentioned in lines 3, 4 and 5 above were in conformance with the rules of the Michigan Board of Land Surveyors or by a Decree of a Court of Law; established, re-established, monumented, recovered, found as expressed below:

NOTE: Not more than 2 corners, all in the same town and range, may be recorded on this certificate.

	A	B	C	D	E	F	G	H	I	J	K	L	M
1													
2	6		5		4		3		2		1		
3													
4	7		8		9		10		11		12		
5													
6	18		17		16		15		14		13		
7													
8	19		20		21		22		23		24		
9													
10	30		29		28		27		26		25		
11													
12	31		32		33		34		35		36		
13													

A. Description of original monument and accessories and/or subsequent restoration:

- JOSEPH WAMPLER D.S. SET POST FOR M-2, T1N, R1E IN FEBRUARY 1824.
TAMARACK 8" N12W 289LKS (190.7')
"NO OTHER TREE"
- CORNER NOT SET IN ORIGINAL GOVERNMENT SURVEY
- THERE IS NO PUBLIC RECORD OF ESTABLISHMENT OF THE CORNER BY THE INGHAM COUNTY SURVEYOR.
- AUSTIN WILLIAMS RLS 21275 USED CORNER IN ACT 132 SURVEYS RECORDED IN LIBER 3 PAGE 425 IN MAY 1978 AND LIBER 4 PAGE 646 IN SEPTEMBER 1981 AND RECORDED IT IN LIBER 5 PAGE 152 OF CORNERS IN JANUARY 1979 AS 1/2" ROD SET AT INTERSECTION OF FENCES NORTH, SOUTH AND EAST. NAIL & TAG 10" ELM, NORTH, 10.10'; NAIL & TAG 8" ELM, S30°E, 13.40'
NAIL & TAG 8" ELM, N45°E, 28.00'.
- GEORGE YOUNG, RLS 17640, USED CORNER IN AN ACT 132 SURVEY RECORDED IN LIBER 4 PAGE 552 IN JUNE 1982 WITH SAME MONUMENT AND WITNESSES AS ITEM 4.

B. Description of corner evidence found and/or method applied in restoring or reestablishing corner:

SEARCHED AT APPARENT LOCATION OF CORNER AND FOUND 1/2" BAR AND CAP #21275 IN OLD ANCHOR POST HOLE 59.44' SOUTH OF M-2, T1N, R1E (3/4" BAR & PA 345 PS 30090 CAP). TRAVERSED ALL OF SECTION 6 AND ACCEPTED BAR & CAP AS CORNER BECAUSE OF CLOSE RELATIONSHIP TO PROPORTIONAL MEASUREMENT IN RELATION TO THE STANDARD LINE, LONG USAGE AND THE FACT THAT I CANNOT THINK OF A BETTER PLACE FOR IT. AMENDED CORNER LOCATION BY EXTENDING EAST-WEST 1/4 LINE 1.68' WEST TO THE STANDARD LINE. SET 3/4" BAR & PA 345 CAP AT THIS LOCATION. CORNER STILL FALLS IN ANCHOR POST HOLE. MEASURED NORTH 2703.56' TO A-1. MEASURED SOUTH 2678.87' TO A-3. MEASURED EAST 2304.30' TO B-2.


C. Description of monument for corner and accessories established to perpetuate locating the position of the corner:

A-2 T1N R2E
3/4" X 24" SMOOTH STEEL BAR WITH YELLOW PLASTIC CAP IMPRINTED PA 345 PS 25837
3/4" BAR WITH YELLOW PLASTIC CAP IMPRINTED PA 345 PS 30090 (DAVE LOHR), (M-2, T1N, R1E), 0° NAZ, 59.44'
SET NAIL AND TAG # 25837 IN SOUTH SIDE 7" ASH, 86° NAZ., 18.70'
FOUND NAIL AND TAG # 30090 IN WEST SIDE 15" ASH, 357° NAZ., 11.04'
1/2" BAR & CAP 21275 (OFF LINE MONUMENT), 90° NAZ., 1.68'
SET NAIL & TAG #25837 IN WEST SIDE 10" ASH, 157° NAZ., 13.90'
SET NAIL AND TAG #25837 IN EAST SIDE 13" ASH, 182° NAZ., 36.30'
CORNER LIES 10' EAST OF CENTERLINE OPEN COUNTY DRAIN

Signed by David L. Clifford

Date OCTOBER 25, 1997

Surveyor's Michigan License No. 25837

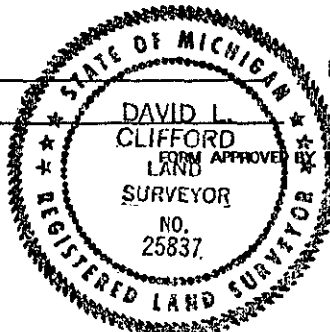

APPROVED BY _____
MICHIGAN STATE BOARD OF PROFESSIONAL SURVEYORS,
JAN. 28, 1971
REVISED MAY 14, 1975
REVISED JAN., 1983
REVISED OCT., 1995

P.A. 345 INGHAM COUNTY
PEER APPROVED 10/30/97 ML