

DEC 1 2 1997

COMMISSION

LAND CORNER RECORDATION CERTIFICATE
Filing Requirement of Act 74, Mich. P.A. 1970

Liber 9 Page 266

For corners in

INGHAM COUNTY Located In: Corner Code #
(County)
STOCKBRIDGE TOWNSHIP
1. Public Land Survey T 1N R 2E B-1
T R
T R
T R
2. Property Controlling S T R
in Section S T R
3. Miscellaneous S T R
Property in Sec. S T R

FILED

970044058
11/05/1997 12:39:52
REGISTER OF DEEDS
Paula Johnson
INGHAM COUNTY, MI

Register of Deeds Stamp & File Number

4. Lot No. _____, Recorded Plat _____
5. Private Claims _____

	A	B	C	D	E	F	G	H	I	J	K	L	M
1		⊙											
2	6		5		4		3		2		1		
3													
4	7		8		9		10		11		12		
5													
6	18		17		16		15		14		13		
7													
8	19		20		21		22		23		24		
9													
10	30		29		28		27		26		25		
11													
12	31		32		33		34		35		36		
13													

I, DAVID L. CLIFFORD, in a field survey on OCTOBER 3 19 97 do hereby state that under requirements of P.A. 74, Michigan P.A. of 1970, the corner points mentioned in lines 1 and 2 above were in conformance with regulations and rules therefore as required in the current manual of survey instructions of the United States Department of the Interior, Bureau of Land Management or by a decree of a Court of Law and /or that the corner points mentioned in lines 3, 4 and 5 above were in conformance with the rules of the Michigan Board of Land Surveyors or by a Decree of a Court of Law; established, re-established, monumented, recovered, found as expressed below:

NOTE: Not more than 2 corners, all in the same town and range, may be recorded on this certificate.

A. Description of original monument and accessories and/or subsequent restoration:

- CORNER NOT SET IN ORIGINAL GOVERNMENT SURVEY.
- JOHN YOKUM, FORMER WASHTENAW COUNTY SURVEYOR APPARENTLY USED CORNER WHILE MEASURING THE NORTH-SOUTH 1/4 LINE OF SECTION 6. THIS INFORMATION IS RECORDED IN HIS PRIVATE RECORDS (NOW IN THE POSSESSION OF WOLVERINE ENGINEERS AND SURVEYORS). THESE RECORDS ARE IN A BOUND FIELD BOOK DATED 1878.

B. Description of corner evidence found and/or method applied in restoring or reestablishing corner:

SEARCHED AT APPARENT LOCATION OF CORNER(ON AN EAST-WEST FENCE LINE 190' TO 220 FEET WEST OF B-13, T2N, R2W). EXCAVATED 30' BY 4' HOLE 2' DEEP ALONG SAID FENCE LINE AND FOUND NO HISTORICAL EVIDENCE OF CORNER. FOUND A 1/2" BAR & CAP #25832 IN FENCE LINE 106.6 FEET WEST OF STANDARD CORNER. THIS IS THE MEAN OF THE FALLING AT NORTHEAST AND NORTHWEST CORNERS OF THE SECTION AND I DO NOT BELIEVE THAT THIS IS THE PROPER METHOD TO USE IN A LOST CORNER REESTABLISHMENT OF THE NORTH 1/4 CORNER OF SECTION 6. CONSIDERED THIS A LOST CORNER AND SET 3/4" BAR & CAP ON STANDARD LINE BY PROPORTIONATE MEASUREMENT IN RELATION TO GLO FALLING AT NORTHEAST CORNER OF SECTION 6. CORNER LIES 213.2 FEET WEST OF B-13, T2N, R2W THE SAME FALLING AS AT THE NORTHEAST CORNER OF SECTION 6. MEASURED EAST 2657.20' TO C-1. MEASURED WEST 2269.80' TO A-1. MEASURED SOUTH 2691.24 TO B-2


C. Description of monument for corner and accessories established to perpetuate locating the position of the corner:

- 3/4" X 24' SMOOTH STEEL BAR & YELLOW PLASTIC CAP IMPRINTED PA 345 PS 25837
- N.E. CORNER 10" I-BEAM ANCHOR POST, 269° NAZ, 117.63'
- SET NAIL & TAG #25837 SOUTH SIDE 18" WHITE OAK, 263° NAZ, 142.48'
- SET NAIL & TAG #25837 SOUTH SIDE RAILROAD TIE FENCE POST, 89° NAZ, 20.16'
- SET NAIL & TAG #25837 NORTH SIDE 4" HICKORY, 75° NAZ, 111.88'
- FOUND 1/2" BAR & CAP #25832, 90° NAZ, 106.6'
- FOUND 1/4" STEEL SHAFT & 1/2" BAR & CAP #18998 (B-13, T2N, R2E), 90° NAZ, 213.20'

Signed by *David L. Clifford*

Surveyor's Michigan License No. 25837

Date OCTOBER 29, 1997

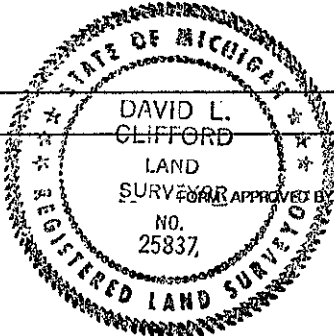

FORM APPROVED BY MICHIGAN STATE BOARD OF PROFESSIONAL SURVEYORS, JAN. 28, 1971
REVISED MAY 14, 1975
REVISED JAN., 1983
REVISED OCT., 1985

P.A. 345 INGHAM COUNTY
PEER APPROVED: 10/16/97 m