

OCT 26 11 41 AM '94

SURVEY & REMONUMENTATION

LAND CORNER RECORDATION CERTIFICATE  
Filing Requirement of Act 74, Mich. P.A. 1970

REGISTER OF DEEDS  
*Paula J. Johnson*  
INGHAM COUNTY, MICH.

For corners in

INGHAM (County)

APR 10 1995

COMMISSION

located in:

Corner Code #

- 1. STOCKBRIDGE TOWNSHIP  
Public Land Survey T 1N R 2E C-3
- 2. Property Controlling in Section S \_\_\_ T \_\_\_ R \_\_\_
- 3. Miscellaneous Property in Sec. S \_\_\_ T \_\_\_ R \_\_\_

Register of Deeds Stamp & File Number

- 4. Lot No. \_\_\_\_\_, Recorded Plat \_\_\_\_\_
- 5. Private Claims \_\_\_\_\_

A	B	C	D	E	F	G	H	I	J	K	L
2	6	5	4	3	2	1					
3	7	8	9	10	11	12					
4											
5											
6	18	17	16	15	14	13					
7											
8	19	20	21	22	23	24					
9											
10	30	29	28	27	26	25					
11											
12	31	32	33	34	35	36					
13											

I, David Clifford, in a field survey on May 30, 19 94, do hereby certify that under requirements of P.A. 74, Michigan P.A. of 1970, the corner points mentioned in lines 1 and 2 above were in conformance with regulations and rules therefore as required in the current manual of survey instructions of the United States Department of the Interior, Bureau of Land Management or by a decree of a Court of Law and/or that the corner points mentioned in lines 3, 4 and 5 above were in conformance with the rules of the Michigan Board of Land Surveyors or by a Decree of a Court of Law; established, re-established, monumented, re-monumented, recovered, found as expressed below:

NOTE: Not more than 4 corners, all in the same town and range, may be recorded on this certificate.

A. Description of original monument and accessories and/or subsequent restoration:

- 1. Original Post set by J. Wampler DS in Nov. 1825  
W. Oak 12 N29E 44  
W. Oak 8 S8W 54
- 2. Corner referred to in the private records (Now in the possession of Wolverine Engineers and Surveyors) of J. Yokum former Washtenaw County Surveyor in 1878 with no mention of mon. or witnesses.


(OVER)

B. Description of corner evidence found and/or method applied in restoring or reestablishing corner:

Searched at apparent location of corner and did not find 1/2" iron as called for by Boss. Only one of his witnesses was still standing and this Oak tree had an Accolade nail & tag in it. Searched and found more Accolade witnesses in other trees. Consulted with Ron Helsel and recieved witnesses to a blue stone that they had found using 2 of Boss's witnesses while they were still standing. Pulled witnesses and found blue stone in ring of small stones. Accepted stone as perpetuation of corner and replaced with Standard Bar and PA 345 Cap.

C. Description of monument for corner and accessories established to perpetuate locating the position of the corner:

- Standard 3/4"X24" Bar and PA 345 Cap PS#25837
- Accolade nail & tag in SW side 20" Oak NAZ 110° 30.71'
- Accolade nail & tag in W. side 8" Hick. NAZ 155° 62.26'
- Accolade nail & tag in N. side 6" Oak NAZ 275° 32.10'
- Accolade nail & tag in S. side 10" Elm NAZ 290° 33.43

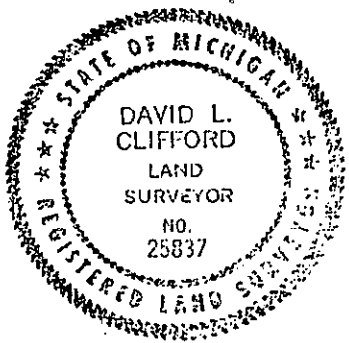

Signed by *David Clifford* Date August 9, 1994

Surveyor's Michigan License No. 25837  
2682

## Part A Continued

3. Oscar Boss recorded corner in May 1974 (Liber 3, page 117 and used in a survey in Nov. 1973 (Liber 2 page 313)  
Found  $\frac{1}{2}$ " bar  
N75W 21.10' Nail s/s 40" Oak  
S70E 31.21' Nail s/s 14" Oak (Only wit. still standing 1994)  
N15E 97.35' Nail w/s 10" Oak
4. A. Williams LS 21275 Used corner in a survey in July 1979 (Liber 3 page 982) with same mon. & witnesses as in item
- 5G. Young LS 17640 used corner in a survey in July 1982 (Liber 4 page 588) with same mon. and witnesses as in item 3
6. M. Mahieu LS #28414 used corner in a survey in July 1989 (Liber 5 page 1137) with same mon. & wit. as in item 3
7. R. Helsel used corner in a survey in March 1991 (Liber 6 page 878) with same mon. & wit. as in item 3