

SURVEY & REMONUMENTATION

APR 10 1995

LAND CORNER RECORDATION CERTIFICATE
Filing Requirement of Act 74, Mich. P.A. 1970

DEC 1 8 05 AM '94

For corners in

INGHAM COUNTY (County)

Located In:

Corner Code #/

STOCKBRIDGE TOWNSHIP

- | | | |
|------------------------------------|-------------------------|-------|
| 1. Public Land Survey | T 1N R 2E | D-2 |
| | T _____ R _____ | _____ |
| | T _____ R _____ | _____ |
| | T _____ R _____ | _____ |
| 2. Property Controlling in Section | S _____ T _____ R _____ | _____ |
| | S _____ T _____ R _____ | _____ |
| 3. Miscellaneous Property in Sec. | S _____ T _____ R _____ | _____ |
| | S _____ T _____ R _____ | _____ |

REGISTER OF DEEDS
INGHAM COUNTY, MICH.

Register of Deeds Stamp & File Number

4. Lot No. _____, Recorded Plat _____
5. Private Claims _____


I, Dave Clifford, in a field survey on Sep 3, 19 94, do hereby certify that under requirements of P.A. 74, Michigan P.A. of 1970, the corner points mentioned in lines 1 and 2 above were in conformance with regulations and rules therefore as required in the current manual of survey instructions of the United States Department of the Interior, Bureau of Land Management or by a decree of a Court of Law and/or that the corner points mentioned in lines 3, 4 and 5 above were in conformance with the rules of the Michigan Board of Land Surveyors or by a Decree of a Court of Law; established, re-established, monumented, re-monumented, recovered, found as expressed below:

NOTE: Not more than 4 corners, all in the same town and range, may be recorded on this certificate.

	A	B	C	D	E	F	G	H	I	J	K	L
2	6		6			4		3		2		
3												
4	7		8		9		10		11			
5												
6	18		17		16		15		14			
7												
8	19		20		21		22		23			
9												
10	30		29		28		27		26			
11												
12	31		32		33		34		35			
13												

A. Description of original monument and accessories and/or subsequent restoration:

- Corner not set in original government surveys
- Corner set by A. Jackson, Co. Surveyor in Aug. 1846 recorded in Vol 1 page 209.
Y. Oak 6 N56 1/2 W 22 1/2 (14.85)
Y. Oak 8 N13 1/2 W 16 1/2 (10.9')

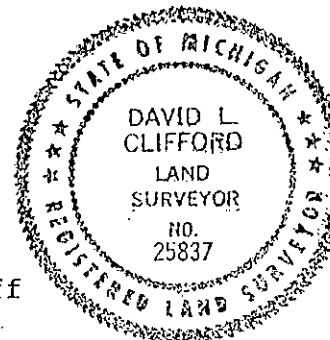

B. Description of corner evidence found and/or method applied in restoring or reestablishing corner:

Searched at apparent location of corner and found squared off wood post in depression in ground on East-West tree line 2' South of East-West fence line on apparent Occupation line to South (very vague occupation line to say the least). Excavated all around stake and found ring of stone. Traversed all of section 5 and found stake to be 6' North and 3.8' West of intersection 1/4 lines. Accepted stake as perpetuation of corner and drove standard bar in top of it and capped with PA 345 cap. Measured East 2661.25. Measured West 2664.57'. Measured North 2591.19. Measured South 2663.50'.

C. Description of monument for corner and accessories established to perpetuate locating the position of the corner:

Standard Ingham County Remonumentation 3/4" Bar and PA 345 Cap PS 25837 in top of square wood post.
Set nail & tag #25837 in N. Side 22" Oak NAZ 271° 12.85'
Set nail & tag #25837 in E. Side 8" Twin Maple NAZ 330° 30.09'
Set nail & tag #25837 in n. Side 18" Oak NAZ 89° 20.17'
Set nail & tag #25837 in S. Side 5" Maple NAZ 56° 43.86'

Signed by Dave Clifford Date Oct. 11, 1994

Surveyor's Michigan License No. 25837