

**SURVEY & REMONUMENTATION**

LIBER 8 PAGE 383

FILED

DEC 1 8 05 AM '94

**LAND CORNER RECORDATION CERTIFICATE**  
Filing Requirement of Act 74, Mich. P.A. 1970

For corners in APR 10 1995  
INGHAM COUNTY

REGISTER OF DEEDS  
*David L. Clifford*  
INGHAM COUNTY, MICH.

(County) **COMMISSION** Located In: \_\_\_\_\_ Corner Code # \_\_\_\_\_

**STOCKBRIDGE TOWNSHIP**

1. Public Land Survey	T <u>1N</u> R <u>2E</u>	<u>E-1</u>
	T _____ R _____	_____
	T _____ R _____	_____
	T _____ R _____	_____
2. Property Controlling	S _____ T _____ R _____	_____
In Section	S _____ T _____ R _____	_____
3. Miscellaneous	S _____ T _____ R _____	_____
Property in Sec.	S _____ T _____ R _____	_____

Register of Deeds Stamp & File Number

4. Lot No. \_\_\_\_\_, Recorded Plat \_\_\_\_\_  
5. Private Claims \_\_\_\_\_

	A	B	C	D	E	F	G	H	I	J	K	L
2	6	5	4	3	2	1						
3												
4	7	8	9	10	11	12						
5												
6	18	17	16	15	14	13						
7												
8	19	20	21	22	23	24						
9												
10	30	29	28	27	26	25						
11												
12	31	32	33	34	35	36						
13												

I, David L. Clifford a field survey on Sep 3, 19 94, do hereby certify that under requirements of P.A. 74, Michigan P.A. of 1970, the corner points mentioned in lines 1 and 2 above were in conformance with regulations and rules therefore as required in the current manual of survey instructions of the United States Department of the Interior, Bureau of Land Management or by a decree of a Court of Law and/or that the corner points mentioned in lines 3, 4 and 5 above were in conformance with the rules of the Michigan Board of Land Surveyors or by a Decree of a Court of Law; established, re-established, monumented, re-monumented, recovered, found as expressed below:

NOTE: Not more than 4 corners, all in the same town and range, may be recorded on this certificate.


- A. Description of original monument and accessories and/or subsequent restoration:
1. Original Post set by J. Wampler DS in Nov. 1825  
Intersected N. Bdy. 296 lks (195.4') W. of post  
Tam 7 S57W 19 1/2  
Tam 8 S46E 41 1/2
  2. Corner referred to in Field Book 15 by W.A. Rowe County Surv. in Oct 1895 as O.P.F. with no mention of witnesses.

(OVER)

B. Description of corner evidence found and/or method applied in restoring or reestablishing corner:  
Searched at apparent location of corner and found 1 1/4" pipe at North end of a very, very, old and indistinct fence (No fence corner- I didnt find one in 1988 either) at the exact GLO falling (195.4') West of the Standard Corner, a 1 1/4" pipe at E13, T2N, R2E. The entire area has been logged since 1988 and so the old witnesses are now stumps. Probed entire area for any signs of historical evidence but found nothing. Accepted 1 1/4" pipe as perpetuation of corner and capped with PA 345 Cap PS# 25837. Corner is on Township Line. Measured East 2691.77 to F1. Measured West 2648.80 to D1.

C. Description of monument for corner and accessories established to perpetuate locating the position of the corner:  
1 1/4" Pipe and PA 345 Cap PS#25837

- Nail & tag #25837 in Top 24" Maple Stump NAZ 34° 13.60'
- Nail & tag #25837 in E. side 12" Maple. NAZ 330° 32.66'
- Nail & tag #25837 in S. side 14" Maple NAZ 82° 30.85'
- 1 1/4" Pipe & PA 345 Cap PS #25837 (E-13, T2N, R2E) East 195.36'

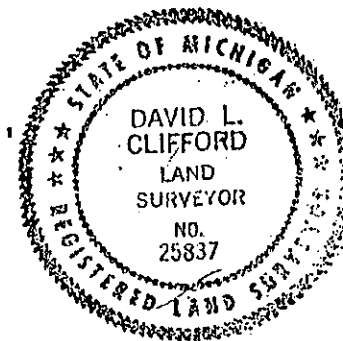

Signed by David Clifford Date Oct 11, 1994  
Surveyor's Michigan License No. 25837

2745

3. This Surveyor recorded corner in June 1988 in Liber 7 of  
Corners page 26 as a 1 $\frac{1}{4}$ " Pipe set at base of fence post to  
South
- 15" Ash S85°E 32.3'
  - 20" Maple N30°E 13.55'
  - 18" Maple N45°W 39.15'
  - 1 $\frac{1}{4}$ " pipe (E13,T2N,R2E) East 195.36' (GLO Falling)

2745