

**SURVEY & REMONUMENTATION**

LIBER 8 PAGE 282

FILED

APR 10 1995

**LAND CORNER RECORDATION CERTIFICATE**

OCT 26 11 42 AM '94

For corners in

Filing Requirement of Act 74, Mich. P.A. 1970

REGISTER OF DEEDS  
INGHAM COUNTY, MICH.

INGHAM (County) Located In: Corner Code ##

STOCKBRIDGE TOWNSHIP

1. Public Land Survey T 1N R 2E E-2  
 T R  
 T R  
 T R

2. Property Controlling S T R  
 in Section S T R  
 3. Miscellaneous S T R  
 Property in Sec. S T R

Register of Deeds Stamp & File Number

4. Lot No. \_\_\_\_\_, Recorded Plat \_\_\_\_\_  
 5. Private Claims \_\_\_\_\_

	A	B	C	D	E	F	G	H	I	J	K	L	M
2	6	5	4	3	2	1							
3													
4	7	8	9	10	11	12							
5													
6	18	17	16	15	14	13							
7													
8	19	20	21	22	23	24							
9													
10	30	29	28	27	26	25							
11													
12	31	32	33	34	35	36							
13													

I, David Clifford, in a field survey on May 30, 19 94, do hereby certify that under requirements of P.A. 74, Michigan P.A. of 1970, the corner points mentioned in lines 1 and 2 above were in conformance with regulations and rules therefore as required in the current manual of survey instructions of the United States Department of the Interior, Bureau of Land Management or by a decree of a Court of Law and/or that the corner points mentioned in lines 3, 4 and 5 above were in conformance with the rules of the Michigan Board of Land Surveyors or by a Decree of a Court of Law; established, re-established, monumented, re-monumented, recovered, found as expressed below:


NOTE: Not more than 4 corners, all in the same town and range, may be recorded on this certificate.

A. Description of original monument and accessories and/or subsequent restoration:

1. Original Post set by J. Wampler DS in Nov. 1825  
 B. Oak 9 S56E 8  
 B. Oak 5 N4W 26
2. Corner used by A. Jackson Co. Surveyor in Aug. 1846 recorded in Vol. 1 page 209 Co. Surv. Records with same mon. and Witnesses as in item #1

B. Description of corner evidence found and/or method applied in restoring or reestablishing corner:

Searched at apparent location of corner and found 2" pipe in remains of 4 way fence corner. The probable remains of the GLO bearing tree mentioned in part A are now almost entirely deteriorated. Excavated all around fence post and found only fence post stones. Accepted 2" pipe as perpetuation of corner and set standard bar and cap in center of it. Measured North 2526.02 to E-1. Measured South 2667.96 to E-3. Measured East 2688.50 to F-2.

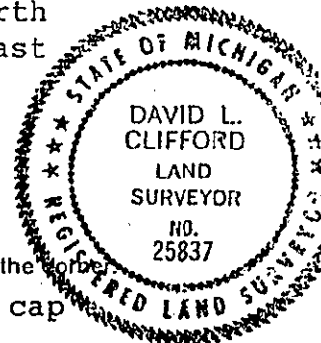

C. Description of monument for corner and accessories established to perpetuate locating the position of the corner:

Standard Ingham Co. Remonumentation 3/4 Bar and P.A. 345 cap PS 25837 in 2" Pipe at N-S-E-W Anchor Post.  
 Set nail & tag #25837 in N.W. Side 20" Oak NAZ 236° 7.46  
 Set nail & tag #25837 in South Side 14" Hick. NAZ 250° 11.09  
 Set nail & tag #25837 in South Side 36" Oak NAZ 270° 7.46'  
 Set nail & tag #25837 in West Side 11" Hick. NAZ 0° 22.56'  
 Set nail & tag #25837 in South Side 18" Cherry NAZ 90° 27.83'

Signed by David Clifford Date July 12, 1994  
 Surveyor's Michigan License No. 25837

2689

3. Corner recorded by this surveyor in July 1988 in Liber 7 of corners page 65 during Super Collider Project as a found 2" pipe at a fence corner post. The remains of a large stump match the GLO call to Black Oak N4W 26 (14.0')  
Nail & Tag #25837 in 15" Cherry East 28.20'  
Nail & Tag #25837 in 20" B. Oak S45°W 7.50'  
Nail & Tag #25837 in 30" B. Oak West 8.42'
4. R. Helsel used corner in a survey in Oct 1993 recorded in Liber 7 of Surveys page 28 with same mon. and witnesses as in item #3

2689

*sample 2003*