

SURVEY & REMONUMENTATION

FILED

LIBER 8 PAGE 276

APR 10 1995

LAND CORNER RECORDATION CERTIFICATE

OCT 26 11:41 AM '94

For corners in

COMMISSION

Filing Requirement of Act 74, Mich. P.A. 1970

REGISTER OF DEEDS

Paul Johnson
INGHAM COUNTY, MICH.

INGHAM

(County)

Located In:

Corner Code #

STOCKBRIDGE TOWNSHIP

- 1. Public Land Survey T 1N R 2E F-1
 T R
 T R
 T R
- 2. Property Controlling S T R
 in Section S T R
- 3. Miscellaneous S T R
 Property in Sec. S T R

Register of Deeds Stamp & File Number

- 4. Lot No. _____, Recorded Plat _____
- 5. Private Claims _____

	A	B	C	D	E	F	G	H	I	J	K	L
2	6		5		4		3		2		1	
3												
4	7		8		9		10		11		12	
5												
6	18		17		16		15		14		13	
7												
8	19		20		21		22		23		24	
9												
10	30		29		28		27		26		25	
11												
12	31		32		33		34		35		36	
13												

I, David Clifford, in a field survey on April 23, 19 94, do hereby certify that under requirements of P.A. 74, Michigan P.A. of 1970, the corner points mentioned in lines 1 and 2 above were in conformance with regulations and rules therefore as required in the current manual of survey instructions of the United States Department of the Interior, Bureau of Land Management or by a decree of a Court of Law and/or that the corner points mentioned in lines 3, 4 and 5 above were in conformance with the rules of the Michigan Board of Land Surveyors or by a Decree of a Court of Law; established, re-established, monumented, re-monumented, recovered, found as expressed below:

NOTE: Not more than 4 corners, all in the same town and range, may be recorded on this certificate.

A. Description of original monument and accessories and/or subsequent restoration:

- 1. Corner Not Set in Original Government Surveys
- 2. Corner Set By T.J. Brown Co. Surv. in Jan. 1858 and recorded in Vol. 2 page 851 Co. Surv. Records
 Hick 10 S74E 19
 W Oak 22 N21W 44


(OVER)

B. Description of corner evidence found and/or method applied in restoring or reestablishing corner:

Searched at apparent location of corner and found 1 1/4" Pipe in Plowed field 2' deep. Probed entire area and discovered nothing more. Tied to only existing occupation line, a Fence line that ends a fractional 1/4 mile South of corner and this agrees closely with location of corner. Accepted 1 1/4" pipe as corner and capped it with standard cap. Measured West 2691.77', to E-1, measured East 2691.33 to G-1, measured South 2455.54 to F-2. All 1988 witnesses still standing.

C. Description of monument for corner and accessories established to perpetuate localing the position of the corner:

4'x 1 1/4" Pipe with PA 345 cap PS #25837
 Set Nail & Tag #25837 in S. Side 21" Oak NAZ 93° 118.50'
 Set Nail & Tag #25837 in N. Side 17" Oak NAZ 117° 202.00'
 Set Nail & Tag #25837 in N. Side 18" Basswood NAZ, 65°, 179.13
 Con. Mon. with PA345 PS#25837 Cap (F-13, White OAK) NAZ 92° 151.80'

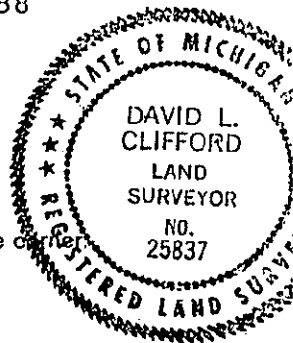

Signed by David Clifford

Date July 12, 1994

Surveyor's Michigan License No. 25837

2686

3. R. Enger LS #28409 Recorded Corner in June 1988 in Liber 7 of Corners pg 71 during Super Collider Project. This Surveyor performed the field work at that time. Corner lies in plowed field and was considered lost. Set 1 $\frac{1}{4}$ " Pipe on Township line Midway between Sec. Corners.
Nail & Tag#18998 (R. Lester) in 15" OAK East 118.48'
Nail & Tag#25837 in 15" Ash N70E 178.3'
Nail & Tag#25837 in 12" Oak S45E 201.35'
Conc. Mon. (F-13, White Oak Twp.) East 151.80'
4. B. Antcliff LS # 25246 used corner on surveys in Oct 1988. during Super Collider Project, recorded in Liber 5, pages 814, 815, 820, and 821 with same mon. and witnesses as item #3

2686