

SURVEY & REMONUMENTATION

LIBER 8 PAGE 278

OCT 26 11 42 AM '94

APR 10 1995

LAND CORNER RECORDATION CERTIFICATE
Filing Requirement of Act 74, Mich. P.A. 1970

For corners in

INGHAM (County)

COMMISSION

Located In:

Corner Code-#

STOCKBRIDGE TOWNSHIP

1. Public Land Survey	T	<u>1N</u>	R	<u>2E</u>	<u>F-2</u>	
	T	_____	R	_____	_____	
	T	_____	R	_____	_____	
	T	_____	R	_____	_____	
2. Property Controlling in Section	S	_____	T	_____	R	_____
	S	_____	T	_____	R	_____
3. Miscellaneous Property in Sec.	S	_____	T	_____	R	_____
	S	_____	T	_____	R	_____

REGISTER OF DEEDS
INGHAM COUNTY, MICH.

Register of Deeds Stamp & File Number

4. Lot No. _____, Recorded Plat _____
5. Private Claims _____

	A	B	C	D	E	F	G	H	I	J	K	L	M
2	6	5						3		2			
3													
4	7	8	9	10	11	12							
5													
6	18	17	16	15	14	13							
7													
8	19	20	21	22	23	24							
9													
10	30	29	28	27	26	25							
11													
12	31	32	33	34	35	36							
13													

I, David Clifford, in a field survey on April 16, 1994

do hereby certify that under requirements of P.A. 74, Michigan P.A. of 1970, the corner points mentioned in lines 1 and 2 above were in conformance with regulations and rules therefore as required in the current manual of survey instructions of the United States Department of the Interior, Bureau of Land Management or by a decree of a Court of Law and/or that the corner points mentioned in lines 3, 4 and 5 above were in conformance with the rules of the Michigan Board of Land Surveyors or by a Decree of a Court of Law; established, re-established, monumented, re-monumented, recovered, found as expressed below:

NOTE: Not more than 4 corners, all in the same town and range, may be recorded on this certificate.


A. Description of original monument and accessories and/or subsequent restoration:

1. Post not set in original Government Survey.
2. Corner set by T.J. Brown Dep. Co. Surv. in 1879 in a 5 acre Survey immediately adjacent to corner R. Oak 20" N3E 25 1/2

(OVER)

B. Description of corner evidence found and/or method applied in restoring or reestablishing corner:

Searched at apparent location of corner and found 1/2" Bar and cap #13574 in rotted off base of anchor post with all of my 1988 witnesses still in existance. Excavated all around post and foug nothing more. Tied occupation lines of T.J. Brown's Survey of 1879 and found that distances matched Brown's distances almost exactly. Accepted bar and cap as perpetuation of corner and drove standard bar and cap in on top of it. Corner is 11' North and 3.8' East of intersec. of 1/4 lines. Measured South 2650.91 to F-3. Measured North 2455.28 to F1. Measured West 2688.50' to E-2. Measured East 2687.80' to G-2.

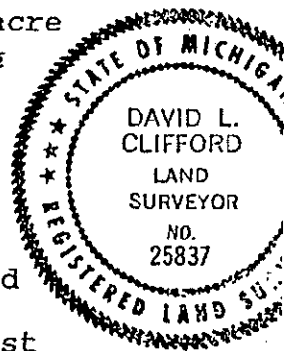

C. Description of monument for corner and accessories established to perpetuate locating the position of the corner:

Standard Ingham County 3/4" Bar and PA 345 Cap #25837 in remains of E-W-N fence corner.
Found nail & tag #25837 in W. Side 16" Cherry Stump Naz 180 6.47'
Set nail & tag #25837 in N. Side 22" Dbl. Oak Naz 260° 6.81'
Set nail & tag #25837 in N. Side 17" Hick. Naz 276° 34.91'
Set nail & tag #25837 in E. Side 22 1/2" Hick. Naz 335° 31.37'
Set nail & tag #25837 in N. Side 8" Oak Naz 86° 50.25'

Signed by

David Clifford

Date July 12, 1994

Surveyor's Michigan License No.

25837

2687

3. Oscar Boss LS 13574 recorded corner in Liber 2 of Corners Page 39 as a found $\frac{1}{2}$ " iron at a fence corner and used Corner in surveys recorded in Liber 1 of surveys page 465 in Aug 1972 and Liber 1 of surveys page 742 in April 1973
S2E 6.47 nail W. side 12" Cherry
S67W 7.61' Nail S. Side 12" Dbl. Oak
N85W 34.86' Nail S. Side 16" Hick.
4. This Surveyor recovered corner during the Super Collider project in June 1988
Found $\frac{1}{2}$ " Bar with cap #13574
Same Witnesses as in item #3 except all are to set nail & cap #25837
5. B. Antcliff L.S. #25826 used corner in a Survey for the Super Collider project in Oct 1988 recorded in Liber 5 of Surveys page 812-815 with same monument and witnesses as in item #3.
6. M. Mahieu LS #18994 used corner in a survey in April 1992 recorded in Liber 6 of Surveys page 321 with no mention of mon. or witnesses.
7. R. Helsel LS 18994 used corner in a survey in April 1992 recorded in Liber 7 of Survey page 29 with same mon. and witnesses as in item #3.

2687