

SURVEY & REMONUMENTATION

FILED

APR 10 1995

LIBER 8 PAGE 272

COMMISSION LAND CORNER RECORDATION CERTIFICATE

OCT 26 11 41 AM '94

Filing Requirement of Act 74; Mich. P.A. 1970

REGISTER OF DEEDS

David Orderson
INGHAM COUNTY, MICH. :

For corners in

<u>INGHAM</u> (County)	Located In:	Corner Code #
STOCKBRIDGE TOWNSHIP	T <u>1N</u> R <u>2E</u>	<u>F-3</u>
1. Public Land Survey	T _____ R _____	_____
	T _____ R _____	_____
	T _____ R _____	_____
	T _____ R _____	_____
2. Property Controlling in Section	S _____ T _____ R _____	_____
	S _____ T _____ R _____	_____
3. Miscellaneous Property in Sec.	S _____ T _____ R _____	_____
	S _____ T _____ R _____	_____

Register of Deeds Stamp & File Number

- 4. Lot No. _____, Recorded Plat _____
- 5. Private Claims _____

A	B	C	D	E	F	G	H	I	J	K	L	M
2	6	5	4	3	2	1						
3												
4	7	8	9	10	11	12						
5												
6	18	17	16	15	14	13						
7												
8	19	20	21	22	23	24						
9												
10	30	29	28	27	26	25						
11												
12	31	32	33	34	35	36						
13												

I, David Clifford, in a field survey on April 16, 19 94, do hereby certify that under requirements of P.A. 74, Michigan P.A. of 1970, the corner points mentioned in lines 1 and 2 above were in conformance with regulations and rules therefore as required in the current manual of survey instructions of the United States Department of the Interior, Bureau of Land Management or by a decree of a Court of Law and/or that the corner points mentioned in lines 3, 4 and 5 above were in conformance with the rules of the Michigan Board of Land Surveyors or by a Decree of a Court of Law; established, re-established, monumented, re-monumented, recovered, found as expressed below:

NOTE: Not more than 4 corners, all in the same town and range, may be recorded on this certificate.

A. Description of original monument and accessories and/or subsequent restoration:

1. Original Post set by J. Wampler D.S. in Nov. 1825
TAM. 4" N88½E 5
TAM. 11 N5E 9½
2. Corner Used by A.P. Drake Co. Surveyor in Jan. 1882 recorded in Vol. 3 page 186
TAM 4" N883/4E 5
TAM 5" N84½W 7


(OVER)

B. Description of corner evidence found and/or method applied in restoring or reestablishing corner:

Searched at apparent location of corner and found 3/4" Pipe buried in Drain Spoil Bank in Very Very old East-South fence line. Probed 30'x30' area (all dry muck) and found no other indication of corner monumentation. All 1988 witnesses still standing. Measured West 2665.99 to E-3, measured East 2699.67 to G-3
Accepted pipe as perpetuation of corner & Set Standard Bar & Cap on top.

C. Description of monument for corner and accessories established to perpetuate locating the position of the corner:

Standard Ingham Co. Remonumentation 3/4 Bar & PA 345 Cap
PS #25837 above 3/4" Pipe
Set Nail & Tag#25837 in E. Side 5" Maple Naz 346° 8.57'
Set Nail & Tag#25837 in N.W. Side 11" Cherry Naz 47° 19.25'
Set Nail & Tag#25837 in N. Side 24" Oak Naz 86° 13.31'
Set Nail & Tag#25837 in E. Side 7" Cherry Naz 136° 19.57'
15' North to centerline Oakley Drain
10' West to centerline Farm Drain

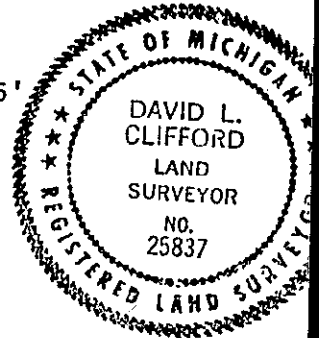

Signed by *David Clifford* Date July 12, 1994

Surveyor's Michigan License No. 25837

2684

P.A. 345 INGHAM COUNTY

3. This Surveyor recorded corner in Liber 7 of corners page 72 in Dec. 1988 during Super Collider Project as a found 3/4" pipe at very old East South-Fence Corner
Spike in 8" Cherry NE 19.5'
Spike in 24" Oak East 13.5'
Spike in 6" Cherry SE 19.3'
4. B. Antcliff LS#25826 used corner in surveys recorded in Jan 1989 in Liber 5 of surveys pages 788-791 with same mon. and witnesses as in item #3.
5. R. Helsel LS#18994 used corner in Surveys dated May 1992 and Sept 1993 recorded in Liber 6 of Surveys page 1207 and Liber 7 page 28 with the same mon. and witnesses as in item #3.

2684