

SURVEY & REMONUMENTATION

LIBER 8 PAGE 389

FILED

APR 10 1995

LAND CORNER RECORDATION CERTIFICATE
Filing Requirement of Act 74, Mich. P.A. 1970

DEC 1 8 06 AM '94

For corners in

INGHAM COUNTY
(County)

Located In:

Corner Code =#

STOCKBRIDGE TOWNSHIP

- | | | |
|------------------------------------|-------------------------|------------|
| 1. Public Land Survey | T <u>1N</u> R <u>2E</u> | <u>G-1</u> |
| | T _____ R _____ | _____ |
| | T _____ R _____ | _____ |
| | T _____ R _____ | _____ |
| 2. Property Controlling in Section | S _____ T _____ R _____ | _____ |
| | S _____ T _____ R _____ | _____ |
| 3. Miscellaneous Property in Sec. | S _____ T _____ R _____ | _____ |
| | S _____ T _____ R _____ | _____ |

REGISTER OF DEEDS
Paul Johnson
INGHAM COUNTY, MICH.

Register of Deeds Stamp & File Number

4. Lot No. _____, Recorded Plat _____
5. Private Claims _____

	A	B	C	D	E	F	G	H	I	J	K	L
2	6	5	4	3	2							
3												
4	7	8	9	10	11							
5												
6	18	17	16	15	14							
7												
8	19	20	21	22	23							
9												
10	30	29	28	27	26							
11												
12	31	32	33	34	35							
13												

I, Dave Clifford, in a field survey on Sep. 3, 19 94, do hereby certify that under requirements of P.A. 74, Michigan P.A. of 1970, the corner points mentioned in lines 1 and 2 above were in conformance with regulations and rules therefore as required in the current manual of survey instructions of the United States Department of the Interior, Bureau of Land Management or by a decree of a Court of Law and/or that the corner points mentioned in lines 3, 4 and 5 above were in conformance with the rules of the Michigan Board of Land Surveyors or by a Decree of a Court of Law; established, re-established, monumented, re-monumented, recovered, found as expressed below:

NOTE: Not more than 4 corners, all in the same town and range, may be recorded on this certificate.

A. Description of original monument and accessories and/or subsequent restoration:

1. Original Post set by J. Wampler D.S. in Aug. 1824 Intersected N. Bdy 174 (114.84') lks West of post Aspen 9 S59W 143(94.38')
2. T.J. Brown Co. Surveyor used corner in a Survey recorded in Vol 2, page 251 in Jan 1851 with no mention of mon. and the same witness as item 1.

(OVER)


B. Description of corner evidence found and/or method applied in restoring or reestablishing corner:

Searched at apparent location of corner and found 3/4" pipe 6.65 North of Anchor post hole. Did not find 1 1/4" pipe off line monument. Dug all around area and found no other evidence of corner. Accepted pipe as Corner and capped with PA 345 cap.

C. Description of monument for corner and accessories established to perpetuate localing the position of the corner:

3/4" Iron Pipe and PA 345 Cap PS #25837, 6' North of Anchor post hole at end of fence from South

- Set Nail & Tag#25837 in S. Side 26" Oak Naz 270° 10.00'
- Set Nail & Tag#25837 in S. Side 27" Oak Naz 80° 30.90'
- Set Nail & Tag#25837 in E. Side 30" Maple Naz 182° 38.43'
- 3/4" pipe & PA 345 Cap PS 25837 (G-13, T2N, R2E) Naz 88° 114.81'

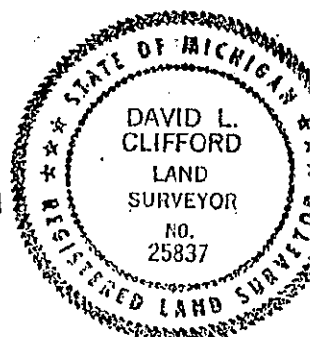

Signed by Dave Clifford

Date Oct. 11, 1994

Surveyor's Michigan License No. 25837

2748

3. MDSH&T Surveyor F.K. Holmes LS 14094 set a 3/4" iron pipe in the North post of a fence from the South for the corner in Sep. 1965

14" Oak N65E 32.72'

14" Oak N45W 12.48'

31" Oak S50W 77.38"

LIBER

4. This surveyor found anchor post used by Holmes for corner while working on the Super Collider Project in Aug. 1988 and used it for direction to set a 3/4" iron pipe 6.65 feet North of it on the Township line for the actual corner. Ron Enger LS 28409 Recorded Corner at this same time in Liber 7 of corners page 75 as a 3/4" pipe.

Nail & Cap #25837 in 26" Oak N80E 37.15'

Nail & Cap #25837 in 24" Triple Maple South 37.15'

Nail & Cap #25837 in 26" Oak West 10.00'

3/4" Pipe (G-13 T2N,R2E) East 114.84'

1 1/4" Pipe (Off line mon.) South 6.65'

Witnesses to off line monument

Nail & Cap #25837 in 26" Oak N65E 32.72'

Nail & Cap #25837 in 26" Oak N45W 12.48'

Nail & Cap #25837 in Triple Maple South 29.9'

2748