

DEC 17 1998

SECTION

LAND CORNER RECORDATION CERTIFICATE
Filing Requirement of Act 74, Mich. P.A. 1970

Liber 9 Page 414

For corners in

<u>INGHAM COUNTY</u> (County)	Located In:	Corner Code #
STOCKBRIDGE TOWNSHIP	T <u>1N</u> R <u>2E</u>	<u>K-3</u>
1. Public Land Survey	T ___ R ___	___
	T ___ R ___	___
	T ___ R ___	___
2. Property Controlling in Section	S ___ T ___ R ___	___
	S ___ T ___ R ___	___
3. Miscellaneous Property in Sec.	S ___ T ___ R ___	___
	S ___ T ___ R ___	___

FILED

980060990
12/01/1998 09:35:58
REGISTER OF DEEDS
Paula Johnson
INGHAM COUNTY, MI

Register of Deeds Stamp & File Number

4. Lot No. _____, Recorded Plat _____
5. Private Claims _____

I, DAVID L. CLIFFORD, in a field survey on MAY 22, 1998. Do hereby state that under requirements of P.A. 74, Michigan P.A. of 1970, the corner points mentioned in lines 1 and 2 above were in conformance with regulations and rules therefore as required in the current manual of survey instructions of the United States Department of the Interior, Bureau of Land Management or by a decree of a Court of Law and /or that the corner points mentioned in lines 3, 4 and 5 above were in conformance with the rules of the Michigan Board of Land Surveyors or by a Decree of a Court of Law; established, re-established, monumented, recovered, found as expressed below:

NOTE: Not more than 2 corners, all in the same town and range, may be recorded on this certificate.

A	B	C	D	E	F	G	H	I	J	K	L	M
1												
2	6	5	4	3	2	1						
3										0		
4	7	8	9	10	11	12						
5												
6	18	17	16	15	14	13						
7												
8	19	20	21	22	23	24						
9												
10	30	29	28	27	26	25						
11												
12	31	32	33	34	35	36						
13												

A. Description of original monument and accessories and/or subsequent restoration:

- JOSEPH WAMPLER D.S. SET POST IN ORIGINAL GOVERNMENT SURVEY IN NOVEMBER 1825, B.O. 18" S11°W 45.5 LKS; W.O. 17" N17°E 11 LKS
- T.J. BROWN, COUNTY SURVEYOR, CALLED CORNER A POST IN A SURVEY RECORDED IN VOLUME 2 PAGE 327 IN JAN 1858
- R. LESTER, RLS #18998, RECORDED CORNER IN LIBER 5 PAGE 304 IN JUNE 1979 AS A SET 4" X 36" CONCRETE MONUMENT WITH 1/2" X 38" REROD WITH CAP #18998. PART B OF THIS CERTIFICATE READS: EXCAVATED A HOLE 6' X 6.4' TO AN AVERAGE DEPTH OF 1.5', MOSTLY EAST OF THE CENTERLINE OF BROGAN ROAD AND ON A FENCE LINE TO THE EAST. FOUND A 1/2" IRON AT ROAD SURFACE SET IN 1" X 3" PIPE 0.2' BELOW THE ROAD SURFACE ± 2.5' EAST OF THE CENTERLINE OF BROGAN ROAD AND ON FENCE LINE TO THE EAST AND TREE/FENCE LINE TO THE WEST. FOUND LARGE TAPERED ROCK 1.6' X 0.9', 1.2' BELOW THE ROAD SURFACE IN SAND LEANING AGAINST AND DIRECTLY UNDER 1/2" IRON SET IN PIPE. MEASURED NORTH ± 2640' TO K-2 AND SOUTH ± 2653' TO K-4. ACCEPTED STONE FOR CORNER AS CALLED FOR BY T.J. BROWN, CO. SURVEYOR. EXCAVATION CONDUCTED BY INGHAM COUNTY SURVEY AND REMONUMENTATION PROJECT. NAIL & TAG #18998 W. SIDE 30" OAK, SE 50.56', NAIL & TAG #18998 N. SIDE 24" OAK NE 38.79', NAIL & TAG #18998 NE SIDE 36" BASSWOOD NW 65.87', NAIL & TAG #18998 SE SIDE 12" TWIN BLACK CHERRY W. 30.88'.
- MAURICE H. MAHIEU, RLS #28414 RECORDED CERTIFIED SURVEY USING CORNER: LIBER 7 PG. 94. FOUND MONUMENT IN MONUMENT BOX WITH CAP #18998, NAIL AND TAG #28414 N. SIDE 24" TWIN CHERRY S80°W 30.52'; NAIL AND TAG #28414 W SIDE 36" OAK N50°E 37.15'; NAIL AND TAG #28414 W. SIDE 48" OAK S30°E 51.20'; AND NAIL AND TAG #28414 E. SIDE 24" OAK S25°W 58.75'.


B. Description of corner evidence found and/or method applied in restoring or reestablishing corner:

SEARCHED AT APPARENT LOCATION OF CORNER AND FOUND A 4" CONCRETE MONUMENT WITH 1/2" BAR & CAP #18998 IN MONUMENT BOX 2' EAST OF CENTERLINE BROGAN ROAD ON FENCE LINE TO EAST AND WEST WITH ALL OF LESTER & MAHIEU'S WITNESSES STILL IN EXISTENCE. ACCEPTED MONUMENT AS PERPETUATION OF CORNER BASED ON R. LESTER'S LCRC INFORMATION & CAPPED IT WITH A 2 1/2" ALUMINUM PA 345 CAP STAMPED 25837.

C. Description of monument for corner and accessories established to perpetuate locating the position of the corner:

K-3 T1N, R2E
4" CONCRETE MONUMENT WITH 1/2" BAR & 2 1/2" ALUMINUM CAP STAMPED PA 345 INGHAM COUNTY 25837 IN MONUMENT BOX.

- FOUND NAIL & TAG #28409 (RON ENGER) E. SIDE 5" OAK 335° NAZ. 54.27'
- FOUND NAIL & TAG #28414 W. SIDE 31" OAK 55° NAZ. 37.15'
- FOUND NAIL & TAG #28414 W. SIDE 36" OAK 155° NAZ. 51.23'
- FOUND NAIL & TAG #28414 E. SIDE OAK 210° NAZ. 58.76'
- FOUND NAIL & TAG #28414 W. SIDE 18" TWIN BLACK CHERRY 257° NAZ. 30.48'

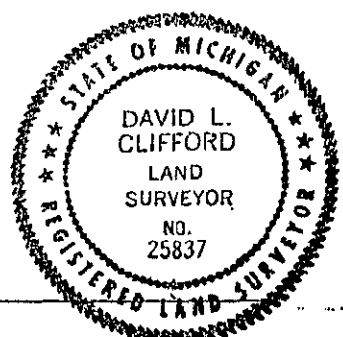

Signed by David Clifford
Surveyor's Michigan License No. 25837

Date AUGUST 7, 1998