

DEC 1 8 1997

COMMISSION

LAND CORNER RECORDATION CERTIFICATE  
Filing Requirement of Act 74, Mich. P.A. 1970

Liber

9 Page 251

For corners in

<u>INGHAM</u>	Located In:	Corner Code #
(County)		
ONONDAGA TOWNSHIP		
1. Public Land Survey	T <u>1N</u> R <u>2W</u>	<u>B-2</u>
	T <u>   </u> R <u>   </u>	<u>   </u>
	T <u>   </u> R <u>   </u>	<u>   </u>
	T <u>   </u> R <u>   </u>	<u>   </u>
2. Property Controlling in Section	S <u>   </u> T <u>   </u> R <u>   </u>	<u>   </u>
	S <u>   </u> T <u>   </u> R <u>   </u>	<u>   </u>
3. Miscellaneous Property in Sec.	S <u>   </u> T <u>   </u> R <u>   </u>	<u>   </u>
	S <u>   </u> T <u>   </u> R <u>   </u>	<u>   </u>

FILED

970041267  
10/20/1997 16:12:58  
REGISTER OF DEEDS  
Paula Johnson  
INGHAM COUNTY, MI

Register of Deeds Stamp & File Number

4. Lot No. \_\_\_\_\_, Recorded Plat \_\_\_\_\_  
5. Private Claims \_\_\_\_\_

I, DAVID L. CLIFFORD, in a field survey on SEPT. 24, 1996 do hereby state that under requirements of P.A. 74, Michigan P.A. of 1970, the corner points mentioned in lines 1 and 2 above were in conformance with regulations and rules therefore as required in the current manual of survey instructions of the United States Department of the Interior, Bureau of Land Management or by a decree of a Court of Law and /or that the corner points mentioned in lines 3, 4 and 5 above were in conformance with the rules of the Michigan Board of Land Surveyors or by a Decree of a Court of Law; established, re-established, monumented, recovered, found as expressed below:

NOTE: Not more than 2 corners, all in the same town and range, may be recorded on this certificate.

	A	B	C	D	E	F	G	H	I	J	K	L	M
1													
2	6			5			4		3		2		1
3													
4	7		8			9		10		11		12	
5													
6	18		17		16		15		14		13		
7													
8	19		20		21		22		23		24		
9													
10	30		29		28		27		26		25		
11													
12	31		32		33		34		35		36		
13													

A. Description of original monument and accessories and/or subsequent restoration:


- POST NOT SET IN ORIGINAL GOVERNMENT SURVEY.
- T. J. BROWN C.O. SURVEYOR SET CORNER AT INTERSECTION OF 1/4 LINES IN A SURVEY RECORDED IN VOL. C PG. 4 WITH NO MENTION OF MONUMENT OR WITNESSES.
- J. STEPHENS LS 16053 RECORDED CORNER IN L 2 PG. 85 IN NOV. 1973 AND USED IN AN ACT 132 SURVEY RECORDED IN L1 PG.30 IN JUNE 1973 AS A T-IRON SET AT INTERSECTION OF 1/4 LINES.  
SURVEY TAG IN WEST SIDE 12" APPLE TREE, N84°12'E, 16.67'  
SURVEY TAG IN EAST SIDE 12" WILD CHERRY TREE, S81°42'W, 11.75'  
SURVEY TAG IN EAST SIDE 5" OAK TREE, N84°48' W, 9.0'

B. Description of corner evidence found and/or method applied in restoring or reestablishing corner:

SEARCHED AT APPARENT LOCATION OF CORNER AND FOUND T-IRON IN EAST-WEST FENCE ROW. AFTER TRAVERSE OF SECTION 6 DETERMINED THAT T-IRON WAS ON NORTH-SOUTH 1/4 LINE AND 0.75' SOUTH OF EAST-WEST 1/4 LINE. EXCAVATED 6" DIAMETER HOLE AND FOUND NO FURTHER EVIDENCE OF HISTORICAL LOCATION OF CORNER. ACCEPTED T-IRON AS PERPETUATION OF CORNER BECAUSE OF CLOSE PROXIMITY TO INTERSECTION OF 1/4 LINES AND LOCATION IN EAST-WEST FENCE ROW. REPLACED T-IRON WITH STANDARD INGHAM COUNTY MONUMENT. MEASURED EAST 2662.66' TP C-2. MEASURED WEST 2752.06' TO A-2. MEASURED NORTH 2698.41' TO B-1. MEASURED SOUTH 2661.66' TO B-3.

C. Description of monument for corner and accessories established to perpetuate locating the position of the corner:

B-2 T1N R2W  
3/4" X 24" SMOOTH STEEL BAR WITH YELLOW PLASTIC CAP IMPRINTED PA 345 CAP LS 25837  
FOUND NAIL AND TAG # 28414 IN NORTH SIDE OF 8" APPLE, 84° NAZ, 16.79'  
FOUND NAIL AND TAG # 28414 IN SOUTH SIDE OF 8" OAK, 90° NAZ, 32.35'  
FOUND NAIL AND TAG # 28414 IN SOUTH SIDE OF 16" CHERRY, 270° NAZ, 13.78'  
FOUND NAIL AND TAG # 28414 IN NORTH SIDE OF 5" OAK, 271° NAZ, 19.96'

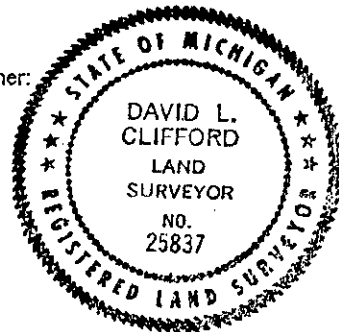

Signed by David L. Clifford

Date JUNE 2, 1997

Surveyor's Michigan License No. 25837

P.A. 345 INGHAM COUNTY  
PEER APPROVED 6/2/97 *ML*