

REMONUMENTATION

DEC 12 1997

LAND CORNER RECORDATION CERTIFICATE
Filing Requirement of Act 74, Mich. P.A. 1970

Liber 9 Page 253

For corners in COMMISSION

<u>INGHAM</u>	Located In:	Corner Code #
(County)		
ONONDAGA TOWNSHIP		
1. Public Land Survey	<u>T.1N. R.2W</u>	<u>C-1</u>
	T. R.	
	T. R.	
	T. R.	
2. Property Controlling in Section	S. T. R.	
	S. T. R.	
3. Miscellaneous Property in Sec.	S. T. R.	
	S. T. R.	
4. Lot No. _____, Recorded Plat _____		
5. Private Claims _____		


FILED

970041269
10/20/1997 16:13:02
REGISTER OF DEEDS
Paula Johnson
INGHAM COUNTY, MI

Register of Deeds Stamp & File Number

I, DAVID L. CLIFFORD, in a field survey on SEPT. 24, 1996 do hereby state that under requirements of P.A. 74, Michigan P.A. of 1970, the corner points mentioned in lines 1 and 2 above were in conformance with regulations and rules therefore as required in the current manual of survey instructions of the United States Department of the Interior, Bureau of Land Management or by a decree of a Court of Law and for that the corner points mentioned in lines 3, 4 and 5 above were in conformance with the rules of the Michigan Board of Land Surveyors or by a Decree of a Court of Law; established, re-established, monumented, recovered, found as expressed below:

NOTE: Not more than 2 corners, all in the same town and range, may be recorded on this certificate.

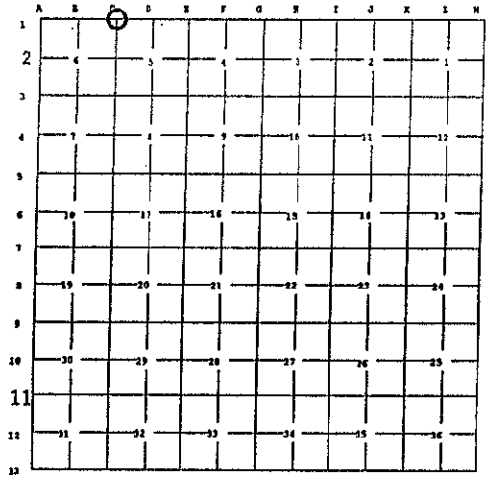

- A. Description of original monument and accessories and/or subsequent restoration:
- JOHN MULLET D.S. SET POST FOR C-13, T2N, R2W IN MAY 1825.
W.O. 30" N19W 5.74(3.8')
B.O. 10" N80-1/2E 508(335.3')
 - HERVEY PARKE SET CORNER 15 LINKS(9.9') EAST OF C-13, T2N, R2W, IN 1826 AND RECORDED 2 NEW WITNESSES.
B.O. 14" S84W 450(297')
DO 12" S44-1/2E 355(234.3')
 - A. JACKSON CO. SURVEY USED CORNER IN SURVEY REC. VOL 1. PG 23 MARCH 1841 WITH SAME MONUMENT AND WITNESSES ITEM A-2.
 - T.J. BROWN, COUNTY SURVEYOR, USED CORNER IN A SURVEY RECORDED IN VOLUME C PAGE 4 WITH SAME WITNESSES AS ITEM A-2.
 - JAMES E. STEPHENS RLS 16053 USED CORNER IN AN ACT 132 SURVEY RECORDED IN LIBER 1 PG 821 IN JUNE 1973 AND RECORDED IT IN LIBER 2 PAGE 521 CORNERS IN SEPTEMBER 1973 AS BOAT SPIKE FOUND IN THE CENTERLINE OF THE TWO SECTION LINE ROADS(PLAINS RD. AND GALE RD.) BOAT SPIKE WAS LEFT IN PLACE AND NEW WITNESSES RECORDED AS:
SURVEY TAG IN THE NE SIDE OF A 24" MAPLE TREE, S44°54'W 38.80'
SURVEY TAG IN THE NE SIDE OF A 24" OAK TREE, S32°50'W 48.75'
SURVEY TAG IN THE NW SIDE OF A 36" OAK TREE, S60°01'E 54.91'


B. Description of corner evidence found and/or method applied in restoring or reestablishing corner:
SEARCHED AT APPEARENT LOCATION OF CORNER AND FOUND 1/2" BAR AND ILLEGIBLE CAP IN MONUMENT BOX 3' NORTH OF CENTERLINE OF PLAINS RD. ON CENTERLINE OF GALE RD. 10' EAST OF C-13 T2N, R2W. PULLED IRON AND DUG DOWN 18" IN MONUMENT BOX AND HIT LARGE POINTED STONE. POINT OF STONE IS UNDER EAST EDGE ON MONUMENT BOX. ACCEPTED STONE AS CORNER AND REPLACED 1/2" BAR WITH STANDARD INGHAM COUNTY MONUMENT. MEASURED WEST 2661.10' TO B-1. MEASURED SOUTH 2678.86' TO C-2.

C. Description of monument for corner and accessories established to perpetuate locating the position of the corner:

C-1 T1N R2W
3/4" X 24" SMOOTH STEEL BAR WITH YELLOW PLASTIC CAP IMPRINTED PA 345 CAP LS 25837 IN MONUMENT BOX 3' NORTH OF CENTERLINE PLAINS RD. ON CENTERLINE GALE RD.
SOUTHWEST CORNER POLE BARN, 30° NAZ., 178.50'
SET NAIL AND TAG # 25837 IN NORTH SIDE POWER POLE, 125° NAZ., 156.15'
FOUND NAIL AND TAG # 28414 IN EAST SIDE OF 28" OAK, 215° NAZ., 52.73'
1/2" BAR IN CONCRETE, 229° NAZ., 46.30'
3/4" X 24" BAR AND PA 345 PS 25837 CAP IN MONUMENT BOX(C-13 T2N, R2W), 275° NAZ., 10.05'
FOUND NAIL AND TAG 28414 IN SOUTH SIDE OF POWER POLE, 295° NAZ., 247.74'
SOUTHEAST CORNER FOUNDATION HOUSE # 6008, 319° NAZ., 99.95'

Signed by David L. Clifford
Surveyor's Michigan License No. 25837

Date SEPTEMBER 25, 1997

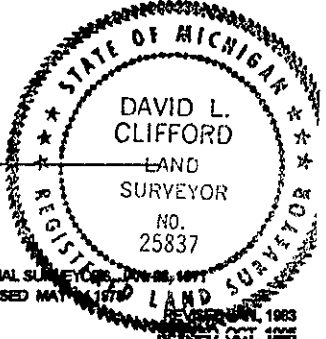

FORM APPROVED BY MICHIGAN STATE BOARD OF PROFESSIONAL SURVEYORS, JAN 28, 1997
REVISED MAY 1970
REVISED OCT, 1995

P.A. 345 INGHAM COUNTY
PEER APPROVED 9/25/97 M