

SURVEY & REMONUMENTATION  
APR 10 1995  
COMMISSION

DEC 1 10 02 AM '94

LAND CORNER RECORDATION CERTIFICATE  
Filing Requirement of Act 74, Mich. P.A. 1970


For corners in  
INGHAM COUNTY  
ONONDAGA TOWNSHIP

Located In:	Corner Code
1N 2W	G-9
T ___ R ___	_____
T ___ R ___	_____
T ___ R ___	_____
T ___ R ___	_____
S ___ T ___ R ___	_____
S ___ T ___ R ___	_____
S ___ T ___ R ___	_____
S ___ T ___ R ___	_____

REGISTER OF DEEDS  
INGHAM COUNTY, MICH.

Register of Deeds Stamp & File Number

4. Lot No. \_\_\_\_\_, Recorded Plat \_\_\_\_\_  
5. Private Claims \_\_\_\_\_

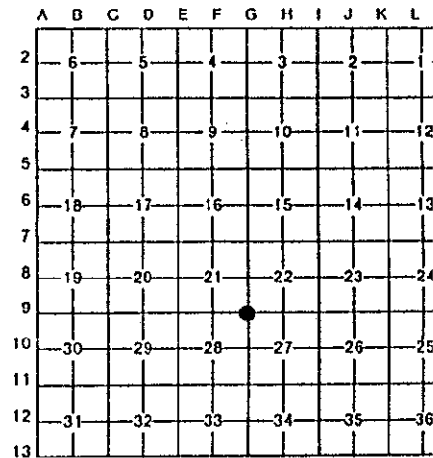


I, RONALD L. ENGER, in a field survey on SEPTEMBER 9, 1994, do hereby certify that under requirements of P.A. 74, Michigan P.A. of 1970, the corner points mentioned in lines 1 and 2 above were in conformance with regulations and rules therefore as required in the current manual of survey instructions of the United States Department of the Interior, Bureau of Land Management or by a decree of a Court of Law and/or that the corner points mentioned in lines 3, 4 and 5 above were in conformance with the rules of the Michigan Board of Land Surveyors or by a Decree of a Court of Law; established, re-established, monumented, re-monumented, recovered, found as expressed below:

NOTE: Not more than 4 corners, all in the same town and range, may be recorded on this certificate.

A. Description of original monument and accessories and/or subsequent restoration:

1. POST SET IN ORIGINAL GOVERNMENT SURVEY BY HERVEY PARKE, DEPUTY SURVEYOR, ON DECEMBER 27, 1825, WITH THE FOLLOWING WITNESSES:  
POPLAR 12 NORTH .10 (6.6')  
DO 12 S34E .10 (6.6')

CONTINUED ON BACK

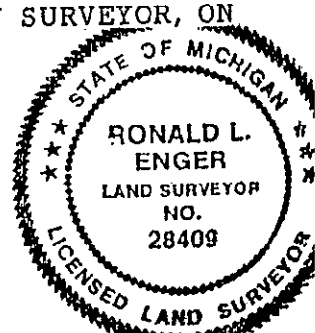

B. Description of corner evidence found and/or method applied in restoring or reestablishing corner:

SEARCHED AT APPARENT LOCATION OF CORNER AND FOUND 1/2" REBAR WITH CAP #18998 ON CENTERLINE OF BELLEVUE ROAD MATCHING 3 OF R. LESTER'S WITNESSES (PART A ITEM 5). CORNER FALLS ON WEST SIDE OF CULVERT PER W. BERRYMAN'S WITNESSES. CORNER IS ON TOP OF 15' OF FILL OVER CULVERT. EXCAVATION WOULD BE FUTILE. AGREED WITH R. LESTER THAT THIS REPRESENTS BEST LOCATION FOR CORNER. REPLACED 1/2" REBAR WITH STANDARD MARKER FOR PA 345 REMONUMENTATION IN INGHAM COUNTY. INSTALLED MONUMENT BOX. MEASURED EAST 2641.31 TO H-9. MEASURED WEST 2631.70 TO CONCRETE MONUMENT AT F-9.

C. Description of monument for corner and accessories established to perpetuate locating the position of the corner:

G-9 T1N R2W  
3/4" DIAMETER X 24" LONG SMOOTH STEEL BAR AND CAP IMPRINTED "PA 345 PS 28409" IN MONUMENT BOX.  
SET 20D GALV. SPIKE & TAG PS 28409 IN NORTH SIDE 17" OAK, 112° AZ., 119.73'  
FOUND NAIL & TAG PS 28414 (M. MAHIEU) IN WEST SIDE 18" PINE, 0° AZ., 65.30'  
SET 20D GALV. SPIKE & TAG PS 28409 IN EAST SIDE 17" PINE, 354° AZ., 78.00'  
FOUND NAIL & TAG PS 18998 IN EAST SIDE UTILITY POLE, 186° AZ., 69.27'

Signed by Ronald L. Enger Date OCTOBER 12, 1994

Surveyor's Michigan License No. 28409  
2750  
P.A. 345 INGHAM COUNTY  
PEER APPROVED 10/12/94 M

REVISED MAY 14, 1993  
REVISED JAN., 1994

G-9 T1N R2W  
PART A CONTINUED

2. A. JACKSON, COUNTY SURVEYOR, USED CORNER IN MAY, 1839, (VOL. 1 PAGE 16); FEBRUARY, 1852, (VOL 2, PAGE 116); AND OCTOBER, 1854 (VOL 2, PAGE 218) WITH THE SAME MONUMENT AND WITNESSES AS ITEM 1.

3. WILLIAM BERRYMAN, COUNTY SURVEYOR, (PRIVATE RECORDS DATE UNKNOWN): SET 3/4" GAS PIPE ON WEST SIDE OF CULVERT ON LINE S 88°30'E OF SOUTH 1/4 POST, SECTION 21, 2605.3' SOUTH OF ANCHOR POST SET AS CENTER OF SECTION 21 AS NEAR AS COULD BE LOCATED ON SECTION LINE.

W. OAK 6" N11W, 108.0'  
2 RED OAKS 6" S85°E 104.6'

4. INGHAM COUNTY ROAD COMMISSION, GRID MAP (IN VERTICAL LETTERS, WHICH INDICATES INFORMATION IS FROM BEFORE 1960) IDENTIFIES MONUMENT AS 3/4" PIPE AND SHOWS 3 WITNESSES:

6" OAK, NNW, 108.0'  
10" CHERRY, W., 52.9'  
6" OAK, E., 104.6'

5. ON A ROUGH DRAFT FOR A LCRC DATED 5-22-81, RONNIE M. LESTER, LS 18998, SURVEYOR FOR THE INGHAM COUNTY SURVEY & REMONUMENTATION PROJECT STATES THAT PROJECT CREWS DID NOT EXCAVATE BECAUSE OF A 48" CULVERT. HE RE-ESTABLISHED CORNER POSITION AT PRORATED GOVERNMENT DISTANCES EAST AND WEST AND ON PHYSICAL CENTERLINE OF BELLEVUE ROAD AND MONUMENTED IT WITH A 1/2" BAR AND CAP. FIVE WITNESSES ARE SHOWN:

TOP CENTER OF 48" CMP, S10°E, 31.70'  
TOP CENTER OF 48" CMP, NORTH, 32.65'  
NAIL AND TAG EAST SIDE 10" PINE, NORTH, 78.00'  
NAIL AND TAG NORTH SIDE 12" OAK, S80°E, 119.73'  
NAIL AND TAG EAST SIDE TELEPHONE POLE, S40°W, 69.27'

2750