

SURVEY & REMONUMENTATION COMMISSION
 APR 10 1995

FILED

DEC 1 10 02 AM '94

LAND CORNER RECORDATION CERTIFICATE
 Filing Requirement of Act 74, Mich. P.A. 1970

For corners in
INGHAM

REGISTER OF DEEDS
David Johnson
 INGHAM COUNTY, MICH.

	Located In:	Corner Code #
(County) ONONDAGA TOWNSHIP		
1. Public Land Survey	T <u>1N</u> R <u>2W</u>	<u>G-11</u>
	T _____ R _____	_____
	T _____ R _____	_____
	T _____ R _____	_____
2. Property Controlling in Section	S _____ T _____ R _____	_____
	S _____ T _____ R _____	_____
3. Miscellaneous Property In Sec.	S _____ T _____ R _____	_____
	S _____ T _____ R _____	_____

Register of Deeds Stamp & File Number

4. Lot No. _____, Recorded Plat _____
 5. Private Claims _____

	A	B	C	D	E	F	G	H	I	J	K	L
2	6	5	4	3	2							
3												
4	7	8	9	10	11	12						
5												
6	13	17	16	15	14	13						
7												
8	19	20	21	22	23	24						
9												
10	30	29	28	27	26	25						
11												
12	31	32	33	34	35	36						
13												


I, **RONALD L. ENGER**, in a field survey on **OCTOBER 26**, 19 **94**, do hereby certify that under requirements of P.A. 74, Michigan P.A. of 1970, the corner points mentioned in lines 1 and 2 above were in conformance with regulations and rules therefore as required in the current manual of survey instructions of the United States Department of the Interior, Bureau of Land Management or by a decree of a Court of Law and/or that the corner points mentioned in lines 3, 4 and 5 above were in conformance with the rules of the Michigan Board of Land Surveyors or by a Decree of a Court of Law; established, re-established, monumented, re-monumented, recovered, found as expressed below:

NOTE: Not more than 4 corners, all in the same town and range, may be recorded on this certificate.

A. Description of original monument and accessories and/or subsequent restoration:

1. POST SET IN ORIGINAL GOVERNMENT SURVEY BY HERVEY PARKE, DEPUTY SURVEYOR, ON DECEMBER 27, 1825, WITH THE FOLLOWING WITNESSES:
 B. OAK 28 S30W 25 (16.5')
 LYNN 20 N30E 24 (15.8')

CONTINUED ON BACK

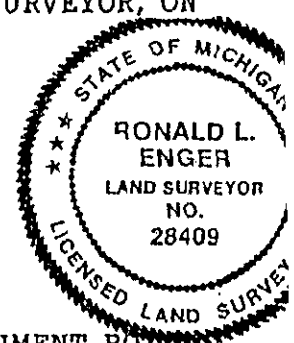

B. Description of corner evidence found and/or method applied in restoring or reestablishing corner:

SEARCHED AT APPARENT LOCATION OF CORNER AND FOUND 3/4" PIPE IN MONUMENT BOX. RELATION TO CENTERLINE OLD PLANK AND OLDS ROADS IN ACCORD WITH BERRYMAN'S CALL. REMOVED PIPE AND EXCAVATED THROUGH BOTTOM OF MONUMENT BOX TO 3.5 FEET DEEP AND FOUND NOTHING. ACCEPTED 3/4" PIPE AS CORNER PER W. BERRYMAN'S NOTES. SET STANDARD MARKER FOR PA 345 REMONUMENTATION IN INGHAM COUNTY IN ITS PLACE.

C. Description of monument for corner and accessories established to perpetuate locating the position of the corner:

- G-11 T1N R2W
 3/4" DIAMETER BY 24" LONG SMOOTH STEEL BAR AND IMPRINTED "PA 345 PS 28409" IN MONUMENT BOX.
 SET PK NAIL & TAG PS 28409 IN CENTERLINE INTERSECTION OF OLD PLANK ROAD AND OLDS ROAD, 184° NAZ., 82.50'
 FOUND NAIL & TAG PS 28414 (M. MAHIEU) IN SOUTH SIDE MULTIPLE 8" BASSWOOD, 312° NAZ., 41.88'
 FOUND NAIL & TAG PS 18994 IN WEST SIDE UTILITY POLE, 33° NAZ., 55.20'
 FOUND NAIL & TAG PS 18994 IN NORTH SIDE ANCHOR POST, 120° NAZ., 106.21'

Signed by Ronald L. Enger Date NOVEMBER 8, 1994

Surveyor's Michigan License No. 28409

2751

P.A. 345 INGHAM COUNTY
 PEER APPROVED 11/9/94

G-11 T1N R2W
PART A CONTINUED

2. A. JACKSON, COUNTY SURVEYOR, USED CORNER IN A SURVEY ON DECEMBER 24, 1851, RECORDED IN VOL. 2, PAGE 104 WITH SAME MONUMENT AND WITNESSES AS ITEM 1.
3. WILLIAM BERRYMAN, COUNTY SURVEYOR, WITNESSED CORNER IN HIS PRIVATE RECORDS
3/4"X 30" IRON PIPE
PK SPIKE CENTERLINE PLANK AND TOMPKINS RD. S0°30'E 82.50'
N. 2.30' TO CENTERLINE OLDS RD.
S62°30'W 58.22; TO VERTICAL SPK. IN NOTCH OF E. ROOT OF 30" ELM
S52°E 58.14' TO HORIZONTAL SPK IN 6" ELM
N26°E 56.24' CENT. TRANSFORMER POLE
4. INGHAM COUNTY ROAD COMMISSION GRID MAP
SAME MONUMENT AND WITNESSES AS ITEM 3.
5. L. HENDRYX, LS 3278, RECORDED CORNER IN APRIL 1978, (LIBER 4 OF CORNERS, PAGE 193)
AND USED CORNER IN A SURVEY IN MAY 1978 (LIBER 3, PAGE 446).
1" GAS PIPE
INGHAM COUNTY TAG IN 6" ASH NW 41.45'
PK NAIL E. SIDE 14" CHERRY NNW 128.75'
PK NAIL E. SIDE PP NE 56.47'
6. R. HELSEL LS 18994 USED CORNER IN A SURVEY IN NOVEMBER 1992 (LIBER 6 OF SURVEYS,
PAGE 1205).
FD PIPE IN CENTERLINE OLDS RD. ON EXT CENTERLINE TOMPKINS
NAIL AND TAG W. SIDE PP N25°E 55.20'
NAIL AND TAG SW SIDE ELM TREE CLUMP N50°W 41.93'
NAIL AND TAG E. SIDE 18" ELM N40°W 41.20'
NAIL AND TAG N. SIDE ANC. POST S65°E 106.28'

2751