

DEC 1 10 02 AM '94

REGISTER OF DEEDS
Ingham County, Mich.

SURVEY & REMONUMENTATION
APR 10 1995
COMMISSION

LAND CORNER RECORDATION CERTIFICATE
Filing Requirement of Act 74, Mich. P.A. 1970

For corners in _____
 INGHAM COUNTY
 (County) ONONDAGA TOWNSHIP

Related In: _____ Corner Code: H-9

1. Public Land Survey	T	1N	R	2W	H-9
	T		R		
	T		R		
	T		R		
2. Property Controlling in Section	S		T	R	
	S		T	R	
3. Miscellaneous Property in Sec.	S		T	R	
	S		T	R	

Register of Deeds Stamp & File Number

- 4. Lot No. _____, Recorded Plat _____
- 5. Private Claims _____

A	B	C	D	E	F	G	H	I	J	K	L
2	6	5	4	3	2	1					
3											
4	7	8	9	10	11	12					
5											
6	18	17	16	15	14	13					
7											
8	19	20	21	22	23	24					
9											
10	30	29	28	27	26	25					
11											
12	31	32	33	34	35	36					
13											

I, RONALD L. ENGER, in a field survey on SEPTEMBER 2, 1994, do hereby certify that under requirements of P.A. 74, Michigan P.A. of 1970, the corner points mentioned in lines 1 and 2 above were in conformance with regulations and rules therefore as required in the current manual of survey instructions of the United States Department of the Interior, Bureau of Land Management or by a decree of a Court of Law and/or that the corner points mentioned in lines 3, 4 and 5 above were in conformance with the rules of the Michigan Board of Land Surveyors or by a Decree of a Court of Law; established, re-established, monumented, re-monumented, recovered, found as expressed below:

NOTE: Not more than 4 corners, all in the same town and range, may be recorded on this certificate.

A. Description of original monument and accessories and/or subsequent restoration:


- 1. POST SET IN ORIGINAL GOVERNMENT SURVEY BY HERVEY PARKE, DEPUTY SURVEYOR, ON DECEMBER 29, 1825, WITH THE FOLLOWING WITNESSES:
 B. OAK 30 N42E .83 (54.8')
 W. OAK 14 S32W .31 (20.5')

2. A. JACKSON, COUNTY SURVEYOR, USED CORNER IN A SURVEY IN OCTOBER, 1854, RECORDED IN VOL 2, PAGE 218, WITH SAME MONUMENT AND WITNESSES AS IN ITEM 1.

CONTINUED ON BACK

B. Description of corner evidence found and/or method applied in restoring or reestablishing corner:

SEARCHED AT APPARENT LOCATION OF CORNER AND FOUND 4" CONCRETE MONUMENT WITH 1/2" BAR & CAP PS 18998 ON THE CENTERLINE OF BELLEVUE ROAD AND ON OCCUPATION LINES TO NORTH & SOUTH AND PROVED IT TO BE IN POSITION RECORDED BY R. LESTER (PART A ITEM 6) BY HIS HICKORY TREE WITNESSES. ACCEPTED THE CONCRETE MONUMENT AS PERPETUATION OF THE CORNER POSITION AS DESCRIBED BY R. LESTER. LEFT CONCRETE MONUMENT IN PLACE, REMOVED LESTER'S CAP AND RECAPPED THE MONUMENT WITH PA 345 CAP.

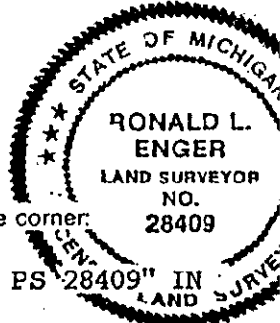

C. Description of monument for corner and accessories established to perpetuate locating the position of the corner:

- H-9 T1N R2W
 4" DIAMETER CONCRETE AND REBAR MONUMENT WITH CAP IMPRINTED "PA 345 PS 28409" IN MONUMENT BOX.
 FOUND NAIL & TAG PS 28414 (M. MAHIEU) IN NORTH SIDE 29" HICKORY, 250° AZ., 100.76
 FOUND NAIL & TAG PS 28414 IN EAST SIDE 23" HICKORY, 180° AZ., 35.70'
 FOUND NAIL & TAG PS 28414 IN NORTH SIDE 12" HICKORY, 138° AZ., 46.65'
 FOUND NAIL & WHITE TAG IN RAILROAD TIE FENCE POST, 20° AZ., 33.58'

Signed by Ronald L. Enger Date OCTOBER 12, 1994

Surveyor's Michigan License No. 28409

P.A. 345-INGHAM COUNTY FORM APPROVED BY MICHIGAN STATE BOARD OF LAND SURVEYORS, JAN. 28, 1978

PEER APPROVED 10/12/94

2752

REVISED MAY 14, 1978
REVISED JAN., 1984

H-9 T1N R2W
PART A CONTINUED

3. E.A. CALKINS, COUNTY SURVEYOR, WITNESSED CORNER IN FEBRUARY, 1901 (FILE FOLDER #1 COUNTY REGISTER OF DEEDS OFFICE)
HICK 8 S5W 51½ (34.0')
HICK 8 N5W 47 (31.0')
4. WILLIAM BERRYMAN, COUNTY SURVEYOR, IN HIS PRIVATE RECORDS, CALLED MONUMENT TO BE A POINTED STONE (CROCKERY 2" DOWN) AND SHOWS 2 WITNESSES:
HICKORY, 14", S 35.0'
HICKORY 10", SW, 101.1'.
5. INGHAM COUNTY ROAD COMMISSION -- GRID MAP (IN VERTICAL LETTERS, WHICH INDICATES INFORMATION IS FROM BEFORE 1960) IDENTIFIES MONUMENT AS "STONE, CROCKERY" AND SHOWS SAME WITNESSES AS IN ITEM 4.
5. RONNIE M. LESTER, LS #18998, LCRC RECORDED IN LIBER 4 OF CORNERS, PAGE 371. INGHAM COUNTY SURVEY & REMONUMENTATION (ICSR) PROJECT CREW EXCAVATED ON JUNE 13, 1978 AND FOUND POINTED ROCK SURROUNDED BY CLAY TILE AND CROCKERY WHICH LESTER ACCEPTED AS BERRYMAN'S PERPETUATION AND REMONUMENTED WITH 4" BY 36" CONCRETE MONUMENT WITH 1/2" X 38" REROD AND CAP LS 18998 AND MADE 4 WITNESSES:
NAIL AND TAG #18998 W. SIDE 24" HICKORY, SOUTH, 35.03'
NAIL AND TAG #18998 SW SIDE 12" HICKORY, SE, 46.97'
NAIL AND TAG #18998 NE SIDE 30" WHITE OAK, SE, 80.97'
NAIL AND TAG #18998 S. SIDE 10" POPLAR, NE, 69.12'
6. JAMES A. PORTER, LS 19003, USED CORNER IN A SURVEY DATED 9-19-78 AND RECORDED IN LIBER 3 OF SURVEYS, PAGE 1165 WITH NO MENTION OF MONUMENT OR WITNESSES.

2752