

DEC 1 10 02 AM '94

SURVEY & REMONUMENTATION

LAND CORNER RECORDATION CERTIFICATE  
Filing Requirement of Act 74, Mich. P.A. 1970

REGISTER OF DEEDS  
Ingham County, Mich.

For corners in INGHAM COUNTY

ONONDAGA TOWNSHIP

APR 10 1995  
COMMISSION

Located In: Corner Code #/

1. Public Land Survey	T	IN	R	2W	H-10
	T		R		
	T		R		
	T		R		
2. Property Controlling in Section	S		T	R	
	S		T	R	
3. Miscellaneous Property in Sec.	S		T	R	
	S		T	R	

Register of Deeds Stamp & File Number

4. Lot No. \_\_\_\_\_, Recorded Plat \_\_\_\_\_  
5. Private Claims \_\_\_\_\_

A	B	C	D	E	F	G	H	I	J	K	L
2	6	5	4	3	2	1					
3											
4	7	8	9	10	11	12					
5											
6	18	17	16	15	14	13					
7											
8	19	20	21	22	23	24					
9											
10	30	29	28	27	26	25					
11											
12	31	32	33	34	35	36					
13											

RONALD L. ENGER SEPTEMBER 16 1994

I, RONALD L. ENGER, in a field survey on SEPTEMBER 16, 1994, do hereby certify that under requirements of P.A. 74, Michigan P.A. of 1970, the corner points mentioned in lines 1 and 2 above were in conformance with regulations and rules therefore as required in the current manual of survey instructions of the United States Department of the Interior, Bureau of Land Management or by a decree of a Court of Law and/or that the corner points mentioned in lines 3, 4 and 5 above were in conformance with the rules of the Michigan Board of Land Surveyors or by a Decree of a Court of Law; established, re-established, monumented, re-monumented, recovered, found as expressed below:

NOTE: Not more than 4 corners, all in the same town and range, may be recorded on this certificate.

A. Description of original monument and accessories and/or subsequent restoration:

1. SURVEY IN FOLDER NO. 1, PAGE 40 OF DATA GATHERED FOR INGHAM COUNTY SURVEY AND REMONUMENTATION PROJECT IN 1970'S (ALSO AVAILABLE IN COUNTY REGISTER OF DEEDS OFFICE) IS SUBDIVISION OF THE NW 1/4 (SURVEYS NO. 307, 308 AND 309) AND ALSO SHOWS THE SW1/4 OF THE SW1/4 (SURVEY NO. 565), DATED APRIL 16, 1847 AND SIGNED BY A. JACKSON, COUNTY SURVEY SHOWS DISTANCE NORTH TO H-9 40.08-1/2 (2645.6') AND WEST TO G-10 40.06 (2644.0') AND TWO WITNESSES:

- B. OAK 30 N76 1/2 E 44
- W. OAK 22 S52 W 55


CONTINUED ON BACK

B. Description of corner evidence found and/or method applied in restoring or reestablishing corner:

SEARCHED AT APPARENT LOCATION OF CORNER AND FOUND 1/2" BAR & CAP PS 25832 (LARRY BRYAN) AT EAST SIDE OF NORTH-SOUTH-EAST ANCHOR POST. EXCAVATED ALL AROUND POST AND FOUND ONLY VARIOUS STONES AROUND NORTH, SOUTH & WEST SIDES OF POST AND A GLOB OF CONCRETE ON EAST SIDE. ACCEPTED POST AS PERPETUATION OF CORNER AND REPLACED 1/2" BAR & CAP WITH STANDARD MARKER FOR PA 345 REMONUMENTATION IN INGHAM COUNTY. MEASURED NORTH 2640.43' TO H-9 AND EAST 2649.04' TO I-10. MEASUREMENTS FROM ENGER SURVEYING AND ENGINEERING JOB 33-147 IN OCTOBER 1993.

C. Description of monument for corner and accessories established to perpetuate locating the position of the corner:

H-10 T1N R2W  
3/4" DIAMETER X 24" LONG SMOOTH STEEL BAR AND CAP IMPRINTED "PA 345 PS 28409"  
SET 20D GALV. SPIKE & TAG PS 28409 IN SOUTH SIDE 14" CHERRY, 110° AZ., 2.50'  
FOUND NAIL & TAG PS 18994 IN EAST SIDE 12" HICKORY, 168° AZ., 21.02'  
SET 20D GALV. SPIKE & TAG PS 28409 IN SOUTHEAST SIDE 19" OAK, 194° AZ., 13.15' E OF MICHIGAN  
FOUND NAIL & TAG PS 18994 IN EAST SIDE 6" ASH, 210° AZ., 4.76'

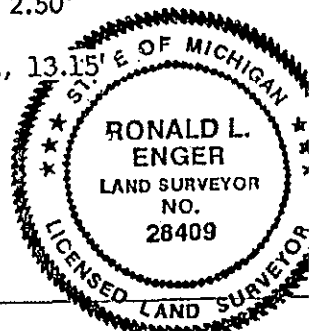

Signed by Ronald L. Enger  
Surveyor's Michigan License No. 28409

Date NOVEMBER 9, 1994

H-10 T1N R2W  
PART A CONTINUED

1. (CONTINUED) SURVEYS 307, 308, AND 309 ARE ALSO SHOWN ON DRAWING IN FOLDER 2, PAGE 41. SURVEY 565 IS ALSO SHOWN IN FOLDER 2, PAGE 40.
2. R. HELSEL, LS #18994, RECORDED CORNER IN APRIL 1993 (LIBER 7 OF CORNERS, PAGE 319) AND USED IN A SURVEY IN MAY 1992 (LIBER 6 OF SURVEYS, PAGE 1149) AS A BAR AND CAP AT BASE OF ANCHOR POST ESTABLISHED BY BRYAN LAND SURVEYS.
  - NAIL AND TAG S. SIDE 16" CHERRY, EAST, 2.17'
  - NAIL AND TAG E. SIDE 8" WALNUT, S45°W, 4.73'
  - NAIL AND TAG E. SIDE 26" OAK, S30°W, 12.35'
  - NAIL AND TAG E. SIDE 12" OAK, S15°E, 21.07'

2753