

LAND CORNER RECORDATION CERTIFICATE
Filing Requirement of Act 74, Mich. P.A. 1970

For corners in

INGHAM

(County)

ONONDAGA TOWNSHIP

Located in:

Corner Code #/

1. Public Land Survey

T IN R 2W H-11

T R

T R

T R

S T R

2. Property Controlling in Section

S T

3. Miscellaneous


S T

Property in Sec.

S T

4. Lot No. Recorded Plat

5. Private Claims

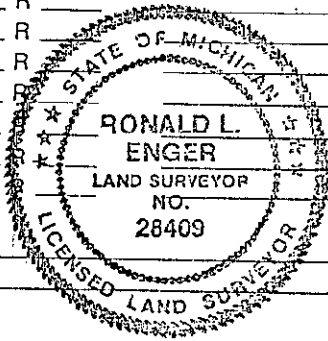

FILED

11/28/1995 09:36:49
REGISTER OF DEEDS
PAULA JOHNSON
INGHAM COUNTY, MI

Register of Deeds Stamp & File Number

Grid table with columns A-L and rows 1-13. A dot is marked at the intersection of column G and row 11.

1. RONALD L. ENGER in a field survey on OCTOBER 19 19 95

do hereby certify that under requirements of P.A. 74, Michigan P.A. of 1970, the corner points mentioned in lines 1 and 2 above were in conformance with regulations and rules therefore as required in the current manual of survey instructions of the United States Department of the Interior, Bureau of Land Management or by a decree of a Court of Law and/or that the corner points mentioned in lines 3, 4 and 5 above were in conformance with the rules of the Michigan Board of Land Surveyors or by a Decree of a Court of Law; established, re-established, monumented, re-monumented, recovered, found as expressed below:

NOTE: Not more than 4 corners, all in the same town and range, may be recorded on this certificate.

A. Description of original monument and accessories and/or subsequent restoration:

1. POST SET IN ORIGINAL GOVERNMENT SURVEY BY HERVEY PARKE, DEPUTY SURVEYOR, ON DECEMBER 27, 1825, WITH THE FOLLOWING WITNESSES: ASPEN 10 S35W 15 (9.9') DO. 14 S89E 39 (25.71')

2. A. JACKSON, CO. SURVEYOR, USED CORNER IN AUG. 1852 (FOLDER#1 PAGE 51), WITH SAME MON. AND WITNESSES AS ITEM 1.

CONTINUED ON BACK

B. Description of corner evidence found and/or method applied in restoring or reestablishing corner:

SEARCHED AT APPARENT LOCATION OF CORNER AND FOUND 1/2" BAR 7' SOUTH OF THE CENTERLINE OF HUNT ROAD. TIED INTO OCCUPATION TO NORTH AND DETERMINED THAT CORNER SHOULD BE 6.8 NORTH OF FOUND IRON. ON OCTOBER 29 1994 EXCAVATED 3' DIAMETER HOLE 3' DEEP INTO ORIGINAL GROUND. FOUND NO EVIDENCE OF CORNER. RETURNED ON OCTOBER 19, 1995 AND EXCAVATED 1'X 2' HOLE ON SOUTH SIDE OF 1ST EXCAVATION. AT A DEPTH OF 4' FOUND POINTED STONE ON SOUTH SIDE OF HOLE. REMOVED STONE (24"X 8" ON BOTTOM X 4" ON TOP) AND FOUND IT SURROUNDED BY BROKEN BRICK AND CROCKERY. ACCEPTED STONE AS CORNER AS PERPETUATED BY A.P. DRAKE, REPLACED IT AND SET 3/4" X 24" SMOOTH STEEL BAR & PA 345 CAP STAMPED PS 28409 ON TOP OF IT. SET MONUMENT BOX.

C. Description of monument for corner and accessories established to perpetuate locating the position of the corner:

H-11 T1N R2W

STANDARD 3/4"X 24" SMOOTH STEEL BAR 1.5' SOUTH OF CENTERLINE HUNT ROAD IN MONUMENT BOX

NAIL & TAG 28409 W. SIDE 36" MAPLE, NAZ 172°, 69.70'

NAIL & TAG 25832 E SIDE 18" ELM, NAZ 332°, 48.55'

NAIL & TAG 28409 N SIDE 5" OAK, NAZ 260°, 60.50'

1/2" REBAR, NAZ 185°, 5.40'

PUNCH MARK IN N. END 36" CMP, NAZ 70°, 36.70'

PUNCH MARK IN S. END 36" CMP, NAZ 128°, 35.02'

Signed by [Signature]

Date NOVEMBER 1, 1995

Surveyor's Michigan License No. 28409

P.A. 345 INGHAM COUNTY
PEER APPROVED 11/7/95 m

H-11 TLN R2W
PART A CONTINUED

3. A.P. DRAKE CO. SURVEYOR USED CORNER IN A SURVEY IN MARCH 1880 RECORDED IN VOL 3 PAGE 167 AS A STONE.
SWP OAK 10 N16W 58 (38.3')
RED ELM 10 S43E 85 (56.1')
4. ING CO. ROAD COMMISSION -- GRID MAP SHOWS STONE CROCKERY, STAKE $\frac{1}{4}$ MILE EAST @ 1/16 COR.
SW COR SCHOOL NE 88.5'
COR POST NW 37.0'
COR POST SW 42.2'
5. L. HENDRYX, LS 3276, RECORDED CORNER IN APRIL 1978 (LIBER 4, PAGE 193) AND USED CORNER IN A SURVEY IN MAY 1978 (LIBER PAGE 446). SET #4 IRON FROM LINE EXTENDED FROM THE PAST FROM SURVEYS
PK NAIL E. SIDE 8" ELM S. 24'- $\frac{1}{2}$ "
PK NAIL E. SIDE 8" ASH SW 17'-2 $\frac{1}{2}$ "
PK NAIL E. SIDE 12 ELM NE 77'-5"
6. G. YOUNG, LS 17640, USED CORNER IN A SURVEY IN NOV., 1985 (LIBER 4, PAGE 1275) WITH SAME MON. AND WIT. AS ITEM 5.
7. R. HELSEL, LS 18994, USED COR IN A SURVEY IN MAY, 1992 WITH SAME MON. AND WIT. AS IN ITEM 5.