

DEC 1 10 03 AM '94

SURVEY & REMONUMENTATION

LAND CORNER RECORDATION CERTIFICATE  
Filing Requirement of Act 74, Mich. P.A. 1970

For corners in

INGHAM

(County)

Located In:

Corner Code #

ONONDAGA TOWNSHIP

1. Public Land Survey

T 1N R 2W

I-9

2. Property Controlling in Section

S T R

3. Miscellaneous Property in Sec.

S T R

REGISTER OF DEEDS  
INGHAM COUNTY, MICH.

Register of Deeds Stamp & File Number

4. Lot No. \_\_\_\_\_, Recorded Plat \_\_\_\_\_  
5. Private Claims \_\_\_\_\_


A	B	C	D	E	F	G	H	I	J	K	L
2	6	5	4	3	2						
3											
4	7	8	9	10	11	12					
5											
6	18	17	16	15	14	13					
7											
8	19	20	21	22	23	24					
9											
10	30	29	28	27	26	25					
11											
12	31	32	33	34	35	36					
13											

I, RONALD L. ENGER in a field survey on SEPTEMBER 2, 1994, do hereby certify that under requirements of P.A. 74, Michigan P.A. of 1970, the corner points mentioned in lines 1 and 2 above were in conformance with regulations and rules therefore as required in the current manual of survey instructions of the United States Department of the Interior, Bureau of Land Management or by a decree of a Court of Law and/or that the corner points mentioned in lines 3, 4 and 5 above were in conformance with the rules of the Michigan Board of Land Surveyors or by a Decree of a Court of Law; established, re-established, monumented, re-monumented, recovered, found as expressed below:

NOTE: Not more than 4 corners, all in the same town and range, may be recorded on this certificate.

A. Description of original monument and accessories and/or subsequent restoration:

1. POST SET IN ORIGINAL GOVERNMENT SURVEY BY HERVEY PARKE, DEPUTY SURVEYOR, ON DECEMBER 25, 1825, WITH THE FOLLOWING WITNESSES:  
TAMARAC 6 S6W .08 (5.3')  
DO. 6 N48E .18 (11.9)

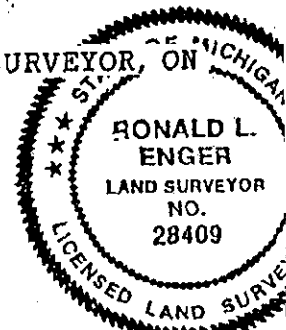

CONTINUED ON BACK

B. Description of corner evidence found and/or method applied in restoring or reestablishing corner:

SEARCHED AT APPARENT LOCATION OF CORNER AND FOUND 1/2" BAR IN CENTERLINE BELLEVUE ROAD ON FENCE LINE TO NORTH. EXCAVATED AROUND BAR AND FOUND ANCIENT 1 1/2" IRON PIPE 12" DEEP ON EAST SIDE OF THE 1/2" BAR. EXCAVATED 2 MORE FEET AND BROKE OFF TOP 18" OF PIPE WHILE ATTEMPTING TO REMOVE IT. COULD NOT REMOVE PIPE WITHOUT BREAKING IT INTO SMALL PIECES. AREA IS IN 5 FEET OF FILL AND COULD NOT GET TO THE BOTTOM OF THE PIPE. BELIEVE THAT ANCIENT PIPE IS PERPETUATION OF CORNER AS DESCRIBED BY J. MULLETT. ALTHOUGH MULLETT WAS NEVER INGHAM COUNTY SURVEYOR, HE WAS A RESIDENT OF INGHAM COUNTY AND WAS A DEPUTY SURVEYOR FOR THE GLO AND WAS PROBABLY COMPETENT TO ESTABLISH OR PERPETUATE CORNERS OF THE UNITED STATES PUBLIC LAND SURVEY SYSTEM. NONE OF D. FLUKES WITNESSES NOW EXIST AND G. YOUNG'S AND M. MAHIEU'S WITNESSES ARE TO A DIFFERENT CORNER. SET STANDARD BAR & PA 345 CAP OVER CENTER OF 1 1/4" PIPE TO REMONUMENT CORNER. SET MONUMENT BOX.

C. Description of monument for corner and accessories established to perpetuate locating the position of the corner:

I-9 T1N R2W  
3/4" BY 24" LONG SMOOTH STEEL BAR AND PA 345 CAP IMPRINTED PS 28409 IN MONUMENT BOX.  
FOUND NAIL & TAG PS 25837 (D. CLIFFORD) IN EAST SIDE CORNER FENCE POST, NAZ 358°, 36.95'  
FOUND NAIL & TAG PS 25837 IN NORTH SIDE UTILITY POLE, NAZ 236°, 125.84'  
SOUTH EDGE OF NO PASSING SIGN POST, NAZ 176°, 22.40'  
NORTHEAST CORNER FOUNDATION FOR HOUSE #4503, NAZ 219°, 153.40'  
CAIRN OF ROCKS IN WIRE CAGE, NAZ 0°, 35.5'  
CORNER IS ON CENTERLINE OF BELLEVUE ROAD AND IN LINE WITH FENCE TO NORTH.

Signed by Ronald L. Enger Date OCTOBER 31, 1994

Surveyor's Michigan License No. 28409

P.A. 345 INGHAM COUNTY  
PEER APPROVED 11/09/94 MC

I-9 T1N R2W  
PART A CONTINUED

2. A. JACKSON, CO. SURVEYOR, USED CORNER IN OCT. 1854 RECORDED IN VOL. 2, PAGE 218.  
TAM 6" S6W 8 (5.3')  
DO. 6" N48E 18 (11.9')  
[MARGINAL NOTE IN THIS SURVEY: "SET IRON POST IN ROAD FOR CORNER OF 22, 23, 25, AND 27, CHARCOAL AND CROCKERY." J.H. MULLET, CO. SURVEYOR (NO DATE)]
3. T.J. BROWN, DEP. COUNTY SURVEYOR, USED CORNER IN A SURVEY IN SEPT. 1872, RECORDED IN VOL. 3, PAGE 63 WITH NO MENTION OF MONUMENT OR WITNESSES.
4. K. DON FLUKE, LS 18988, RECORDED CORNER IN FEB. 1978, (LIBER 4 OF CORNERS, PAGE 126) AND USED IN ACT 132 SURVEYS (LIBER 3, PAGE 224 AND 225)  
 $\frac{1}{2}$ " ROD  
SOUTH 80.07 TELE. POLE  
NORTH 35.97 TELE. POLE  
N50E 84.94 ELM 17"
5. J. PORTER, LS 19003, USED CORNER IN A SURVEY IN JUNE 1978 (LIBER 3, PAGE 1165) WITH NO MENTION OF MONUMENT OR WITNESSES.
6. G. YOUNG, LS 17640, USED CORNER IN A SURVEY IN AUGUST 1986 (LIBER 5, PAGE 57) AND SHOWS WITNESSES TO I-9, T3N, R1W
7. M. MAHIEU, LS 28414, USED CORNER IN JUNE 1992 WITH SAME MONUMENT AND WITNESSES AS ITEM 6 AND USED AGAIN IN JUNE 1993 (LIBER 6, PAGE 1247) WITH SAME MONUMENT AND WITNESSES.